

If well telescopes, please sketch and show depths.

GROUND LEVEL

SECTION _____

Please indicate well location X.

Pump Capacity (GPM) 2500	No. of Stages 1	Setting Depth 70 FT.
------------------------------------	---------------------------	--------------------------------

PUMP TEST

Well yielded NOT TESTED GPM with
a drawdown of _____ ft.
after _____ hours of pumping

LOG DATA

TYPE OF LOG RUN (Check One): No Log Run
 Electric, Gamma Ray, Density, Sonic, Neutron,
 Other (Describe) _____

Name of Organization Running Log

N/A

GEOLOGICAL DATA (Office Use Only)


Surface Elev.	Geologic Unit	Unit Thickness	Depth to Top
Subs SWL	Date	Analysis	Aquifer Test

Driller's Remarks

Layne File No. 22-9246

If more than one screen, show location of each on sketch.

topozone

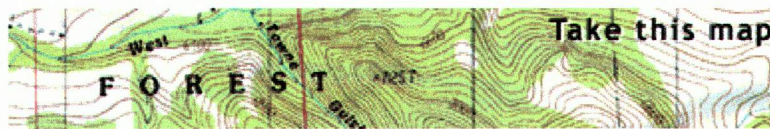

Take this map

VIEW MAPS

GET DATA

MY TOPOZONE

WEB SERVICES

ABOUT US

Map/Photo Info

Topo Download

Photo Download

USGS Topo Maps

1:24K/25K Series

1:100K Series

1:250K Series

Map Size

Small

Medium

Large

View Scale

1 : 50,000

Update Map

Coordinate Format

D/M/S

Coordinate Datum

WGS84/NAD83

Show target

[Email this map](#)

[Bookmark this map](#)

[Print this map](#)

myTopo.com

GET A
CUSTOM
MAP PRINT



33° 53' 00"N, 90° 44' 59"W (WGS84

USGS **Mound Bayou** Quad

[View TopoZone Pro aerial photos, shaded relief, street maps, interact](#)

