County:	Bolivar
Permit #:	GW40394 /
Irri Driller:	gation Equipment
Date dril	ling completed: 10-21-05

State Well Report

Part 1

Mississippi Department of Environmental Quality
Office of Land and Water Resources
P.O. Box 10631
Jackson, MS 39289-0631
(601)961-5210
(601)354-6938 (fax)

For Office Use Only:	
Aquifer:	_
Well #: <u>E-//</u>	-
L. S. Elevation:	_
E-log #:	_

State Law requires that this report be prepared by the driller in detail and filed with the Department within 30 days of completion of drilling of the well

30 days of completion of drilling of the well.				
Well Owner Information	Well Location			
Owner Name David Favi	Latitude: 33 57 80N Longitude: 90 44 7.2W,			
Mailing Address: 704 Argone Ave	Method of Lat/Long (circle one): Conventional Survey,			
	USGS quad, Hand-held GPS, Survey-grade GPS			
Shelby MS 38774	5 W 1/4 N W/4 Sec 5 Twn 24N Rng 5W			
City State Zip Code 662-398-7789 Telephone No. ()	Distance Direction Nearest Town 2 Miles NE of Shelby			
Well I	Data			
Purpose of Well (circle one) Home Industrial Public Supply (Irrigation Fish Culture Other:			
Date well drilling started: 10-21-05 Date w	vell drilling completed: 10-21-05			
If flowing, method of flow regulation: Valve Other (d	escribe)			
Static Water Level: 42' feet above on below (circle one) i	and surface Date measured: 10-24-05			
Method of Measurement (circle one) steel tabe electric tape	air line other:			
Hole depth: 115 Well depth: 115	Well grouted to a depth of			
Type of grout (circle one): Cement Bentonite Mix				
Casing length: 75 feet Casing diameter: 10 inches Type of casing: PVC				
Screen length: 40 feet Screen diameter: 10	inches Type of screen: <u>PVC</u>			
Screen slot size: .050 inches Setting depth: From	76 feet to 115 feet			
Type of completion (circle all applicable): (Gravel packed) Under	reamed Telescoped Open hole Natural Development			
Other (describe):				
Top of lap pipe or reduction in casing: feet. If telescoped or more than one screen, describe on back of page				
Logs run (circle all applicable): No log pan Electric Gamma Ray Density Sonic Neutron Other:				
Name of organization running log(s):	• .			
I certify that the well was drilled, constructed, and completed in accordance with all applicable requirements of the Mississippi				
Department of Environmental Quality and/or the Mississippi Department of Health regulations and state lays.				
Irrigation Equipment Inc. Patrick M. Chism 0695	Patrick M Chin			
Print Name of Water Well Contractor and License No.	Signature of Water Well Contractor			

RECEIVED

NOV 0 7 2005


BY: OLWR

Ground Level

Desci	ription of Formations Encountered	From	To
Clav	# 7 6 G W	1.00	29
Fine	Sand	30	_35
Fine	Sand/gravel Sand/gravel	36	58
Med.	Sand/gravel	59	1.1.5
		ļ	
		ļ	
		ļ	
		<u> </u>	
		-	
		 	
			
		ļ	
		 	
		 	
			
		 	
		 	
		 	
<u> </u>			

If more than one screen, show location of each on sketch

Sketch the property layout and include the following: 1) the well location; 2) any permanent structures on the property that may aid in locating the well; 3) any roads, power lines, or other items that may aid in locating the property and the well; 4) indicate direction.

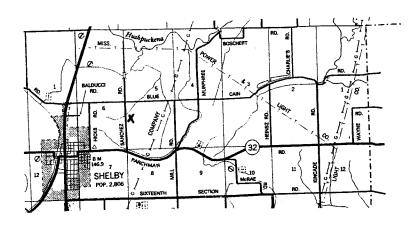

Landowner Name:

Signature of Water Well Contractor

STATE WELL REPORT

Part 2

County: Bolivar
Permit#: GWU0394
Lrrigation Equipment

Date completed: 10-24-05

Pump Installer's Completion Report
Mississippi Department of Environmental Quality
Office of Land and Water Resources
P.O. Box 10631
Jackson, MS 39289-0631
(601)961-5210
(601)354-6938 (fax)

For Office Use Only:		
Aquifer:		
Well #: <u>E-/</u> 2		
Elevation:		

This report should be prepared by the pump installer in detainstallation of pump.		
Well Owner Information	Well Location	
Owner Name: David Favi	Latitude:Longitude:	
Mailing Address: 704 Argone Ave	Method of Lat/Long (circle one): Conventional Survey,	
	USGS quad, Hand-held GPS, Survey-grade GPS	
Shelby, MS 38774 City State Zip Code	¼¼ Sec_ 5 Twn_ 24N Rng_ 5W	
City State Zip Code	Distance Direction Nearest Town	
Telephone No. ()	2 Miles NE of Shelby	
Pump Type	Power Type Circle one	
Circle one Air Lift Jet Submersible	Diesel Engine Gasoline Engine Natural Gas	
Bucket Piston Turbine	Electric Motor Hand Tractor PTO	
Centrifugal Rotary Flowing Well	Windmill Other (specify):	
Other (specify):	Horse Power Rating of Motor: 30	
Date Pump Installed: 10-24-05	Setting Depth: 70 feet	
Rated Pump Capacity: 1200 Gallons Per Minute	Number of Stages:1	
Pump Test Data	Method of Measuring Water Level Circle one	
Date Well Tested:		
Static Water Level (A):Feet Below Land Surface	Air Line Electric Measuring Line Steel Tape Other (specify):	
Pumping Water Level (B):Feet Below Land Surface	Culti (opensy).	
Drawdown [(B) - (A)]:Feet Below Land Surface	For flowing well, measured shut in head:feet	
Test Pumping Rate: Gallons Per Minute	Well yieldedGPM with a drawdown of	
Duration of Pump Test (minimum 4 hours):hours	feet afterhours of pumping	
I HEREBY CERTIFY that the above statements are true to the best	of my banyledge /	
Patrick M. Chism 0695	Patrick M Chini	
Print Name of Pump Installer and License No. (if applicable)	Signature of Pump Installer	

RECEIVED

NOV 0 7 2005

BY: OLWR

Ewdosa4

	State Well Report	For Office Use Only:			
County: Bolivar	Part 1	1			
Permit #:	Mississippi Department of Environmental Quali Office of Land and Water Resources	ty Aquifer:			
Irrigation Equipment	P.O. Box 10631	Well #: <u>E-152</u>			
2:ma	Jackson, MS 39289-0631	L. S. Elevation:			
Date drilling completed: 10-21-05	(601)961-5210	L. S. Elevation.			
	(601)354-6938 (fax)	E-log #:			
State I am manufact that the	41 41 1 1 1 1 1 1 1 1 1 1 1 1 1 1 1 1 1				
30 days of completion of drilling	ort be prepared by the driller in detail and file	d with the Department within			
Well Owner Informa		Vell Location			
David Favi	•				
Owner Name David Favi	Latitude:	N 90 44 73W Longitude:			
Mailing Address: 704 Argone A	ve Method of I at/I one (circl	e one): Conventional Survey,			
	Avenues of Lastong (circle	one). Conventional Survey,			
	USGS quad, Hand-l	eld GPS, Survey-grade GPS			
G1 11		Twn 24N Rng 5W			
Shelby MS 3	8774% Sec	IwnRng			
City State	Zip Code Distance Direction	n Nearest Town			
662-398-7789	2 Miles NE	of <u>Shelby</u>			
Telephone No. ()		_			
	Well Data				
		_			
	strial Public Supply Irrigation Fish Culture	Otter			
Date well drilling started: 10-21.	-05 Date well drilling completed:	10-21-05			
If flowing, method of flow regulation: Valve Other (describe)					
Static Water Level: 42 feet abo	ve on below (circle one) land surface Date measure	d: 10-07-05			
Method of Measurement (circle one) (ste	el tape electric tape air line other.	THE PVC			
Hole depth: 115 Well dept	h: 115 Well grouted to a depth of	SEMENT MAN			
Type of grout (circle one): Cement	Bentonite Mix	DISER			
•	MIX 10	AICT			
Casing length: /5 feet Casing	diameter. 10 inches Type of casing:	PVC			
Screen length: 40 feet Screen diameter: 10 inches Type of screen: PVC					
Screen slot size:050 inches Setting depth: From 76 feet to 115 feet					
Turn of annulation (cl. at all a 1)					
Type of completion (circle all applicable):	Gravel packed Underreamed Telescoped Op	en hole Natural Development			
	Other (describe):				
T 41					
Top of lap pipe or reduction in casing:	feet. If telescoped or more than one s	creen, describe on back of page			
Logs run (circle all applicable): (No log run	Electric Gamma Ray Density Sonic Neutron	Other			
Logs run (circle all applicable): (No log run Electric Gamma Ray Density Sonic Neutron Other:					
Name of organization running log(s):					
I certify that the well was drilled, constructed, and completed in accordance with all applicable requirements of the Mississippi					
Department of Environmental Quality and/or the Mississippi Department of Health regulations and state laws.					
Irrigation Equipme	nt Inc. $/)$ /				
Patrick M. Chism 0695					
Print Name of Water Well Contractor and License No. Signature of Water Well Contractor					

State Well Report