

MAR-24-2006 11:03 From: MID SOUTH WATER

6628431717

To: 360 0535

P.2/4

Well #1

County Bolivar  
 Permit # GW4077A  
 Driller Mike Wells  
 Date drilling completed 3-17-06

**State Well Report**  
**Part I - Driller's Log**  
 Mississippi Department of Environmental Quality  
 Office of Land and Water Resources  
 P.O. Box 10631  
 Jackson, MS 39289-0631  
 (601)961-5210  
 (601)354-6938 (fax)

For Office Use Only:  
 Aquifer: \_\_\_\_\_  
 Well # E-153  
 L. S. Elevation: \_\_\_\_\_  
 E-log #: \_\_\_\_\_

State Law requires that this report be prepared by the license holder responsible for the work and filed with the Department at the above address within 30 days of completion of drilling of the well or borehole.

Information on Well Owner (Landowner if borehole is not for a water well)	Well or Borehole Location
Owner Name <u>Lema Farms Partnership</u> Mailing Address <u>503 Hillcrest Circle</u> <u>Cleveland MS 38132</u> City State Zip Code Telephone No. <u>(662) 843-2470</u>	Latitude: _____ " Longitude: _____ " Method of Lat/Long (circle one): Conventional Survey, USGS quad, Hand-held GPS, Survey-grade GPS NW 1/4 SW 1/4 Sec <u>35</u> Twn <u>24N</u> Rng <u>5W</u> Distance <u>1 1/2</u> Miles Direction <u>NE</u> of Nearest Town <u>Mound Bayou</u>
Well / Borehole Data	
Date drilling started: <u>3-17-06</u> Date drilling completed: <u>3-17-06</u> Hole depth: <u>118'</u> Hole diameter: <u>16"</u> Location of the source of any surface water used for drilling: <u>BAYOU 800 FT SOUTH OF WELL</u> Method of dosing and volume of Chlorine used in drilling and development: <u>102 LB</u> Logs run (circle all applicable): <u>No log run</u> Electric Gamma Ray Density Sonic Neutron Other: _____ Name of organization running log(s): _____ Purpose of borehole (check one): Water Well <input checked="" type="checkbox"/> Geotechnical/Geological Investigation _____ Ground Source Heat Pump _____ Seismic Survey _____ Other (describe) _____ <i>If drilling is not related to water well construction, skip the remainder of this block</i>	
Purpose of Well (check one): Home _____ Industrial _____ Public Supply _____ Irrigation <input checked="" type="checkbox"/> Fish Culture _____ Other: _____ If a flowing well, method of flow regulation: Valve _____ Other (describe) _____ Static Water Level: <u>45</u> feet above or <u>below</u> (circle one) land surface Date measured: <u>3-17-06</u> Method of Measurement (circle one) <u>steel tape</u> electric tape air line other: _____ Well depth: <u>118</u> Well grouted to a depth of <u>10</u> feet Type of grout (circle one): <u>Neat Cement</u> Bentonite Mix Casing length: <u>78</u> feet Casing diameter: <u>16</u> inches Type of casing: <u>PVC</u> Screen length: <u>40</u> feet Screen diameter: <u>16</u> inches Type of screen: <u>PVC</u> Screen slot size: <u>.050</u> inches Setting depth: From <u>78</u> feet to <u>118</u> feet Type of completion (circle all applicable): <u>Gravel packed</u> Underreamed Telescoped Open hole Natural Development Other (describe): _____ Top of tap pipe or reduction in casing: <u>N/A</u> feet <i>If telescoped or more than one screen, describe on next page</i>	

Form: OLWR-SWR-1A

RECEIVED  
 MAR 24 2006  
 BY: OLWR

E-153


Well #1

The sketch below only required for water wells

Description of formations encountered must be provided for all wells and boreholes, unless specifically exempted by regulations

If well telescopes, show depths on sketch

Ground Level

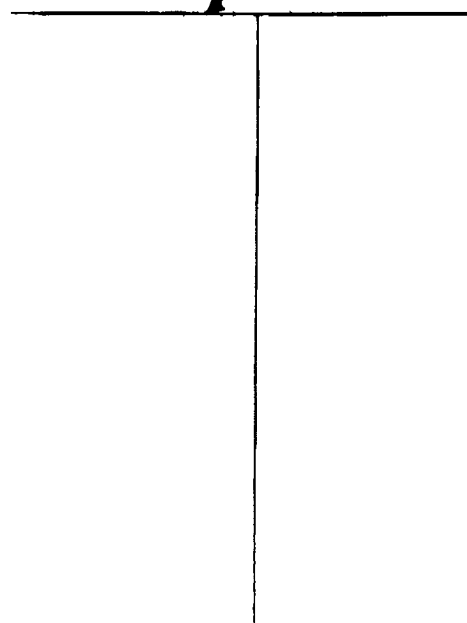

Description of Formations Encountered	From (depth) Ground Level	To (depth)
Clay	0	28
Fine Sand	28	53
Medium Sand	53	75
Course Sand	75	83
Course Sand & Gravel	83	93
Course Sand & Gravel	93	118
Clay	118	

If more than one screen, show location of each on sketch

Sketch the property layout and include the following: 1) the well location; 2) any permanent structures on the property that may aid in locating the well; 3) any roads, power lines, or other items that may aid in locating the property and the well; 4) a north arrow.

Landowner Name: LENA ALLEN

Form: OLWR-SWR-1A

I certify that the well/borehole was drilled, constructed, and completed in accordance with all applicable requirements of the Mississippi Department of Environmental Quality and the Mississippi Department of Health regulations, if applicable, and state laws.

Thomas G. Christman 0-703 3-21-06 Thomas G. Christman

Print Name of Responsible Licensee and License No. Date Signature of Licensee

RECEIVED  
MAR 24 2006  
BY: OLWR

MAR-24-2006 11:03 From: MID SOUTH WATER

6628431717

To: 360 0535

P. 4/4

Well #1

**STATE WELL REPORT**

**Part 2**

**Pump Installer's Completion Report**  
 Mississippi Department of Environmental Quality  
 Office of Land and Water Resources  
 P.O. Box 10631  
 Jackson, MS 39289-0631  
 (601)961-5210  
 (601)354-6938 (fax)

County: Bolivar  
 Permit # \_\_\_\_\_  
 Driller: Mike Wells  
 Date completed: 3-17-06  
*Copy information from block on Part 1*

**For Office Use Only:**  
 Aquifer: \_\_\_\_\_  
 Well #: E-153  
 Elevation: \_\_\_\_\_

*This part of the report must be completed by a licensed water well contractor or a licensed pump installer. A copy of Part 1 of the report must be attached and both parts filed with the Department at the above address within 30 days of well completion.*

Well Owner Information	Well Location
Owner Name: <u>Lema Farms Partnership</u>	Latitude: _____ Longitude: _____
Mailing Address: <u>503 Hillcrest Circle</u>	Method of Lat/Long (check one): Conventional Survey _____
<u>Cleveland MS 38732</u> City State Zip Code	USGS quad _____ Hand-held GPS _____ Survey-grade GPS _____
Telephone No. <u>(662) 843-2470</u>	_____ 1/4 _____ 1/4 Sec. <u>35</u> 1 <u>24</u> N R <u>5W</u>
	Distance _____ Direction <u>34</u> Nearest Town _____
	<u>1 1/2</u> miles <u>N.E.</u> of <u>Mound Bayou</u>

Pump Type (Circle one)	Power Type (Circle one)
Air Lift <input type="checkbox"/> Jet <input type="checkbox"/> <b>Submersible</b> <input checked="" type="checkbox"/>	Diesel Engine <input type="checkbox"/> Gasoline Engine <input type="checkbox"/> Natural Gas <input type="checkbox"/>
Bucket <input type="checkbox"/> Piston <input type="checkbox"/> Turbine <input type="checkbox"/>	<b>Electric Motor</b> <input checked="" type="checkbox"/> Hand <input type="checkbox"/> Tractor PTO <input type="checkbox"/>
Centrifugal <input type="checkbox"/> Rotary <input type="checkbox"/> Flowing Well <input type="checkbox"/>	Windmill <input type="checkbox"/> Other (specify): _____
Other (specify): _____	Horse Power Rating of Motor: <u>30</u>
Date Pump Installed: <u>3-17-06</u>	Setting Depth: <u>76</u> feet
Rated Pump Capacity: <u>1500</u> Gallons Per Minute	Number of Stages: <u>1</u>

Pump Test Data	Method of Measuring Water Level (Circle one)
Date Well Tested: <u>Not tested</u>	Air Line <input type="checkbox"/> Electric Measuring Line <input type="checkbox"/> <b>Steel Tape</b> <input checked="" type="checkbox"/>
Static Water Level (A): <u>45</u> Feet Below Land Surface	Other (specify): _____
Pumping Water Level (B): <u>N/A</u> Feet Below Land Surface	For flowing well, measured shut in head: <u>N/A</u> feet
Drawdown [(B) - (A)]: <u>N/A</u> Feet Below Land Surface	Well yielded <u>N/A</u> GPM with a drawdown of _____
Test Pumping Rate: <u>N/A</u> Gallons Per Minute	_____ feet after _____ hours of pumping
Duration of Pump Test (minimum 4 hours): <u>N/A</u> hours	

I HEREBY CERTIFY that the above statements are true to the best of my knowledge.

Thomas G. Chrestman 0-703 Thomas G. Chrestman  
 Print Name of Pump Installer and License No. (if applicable) Signature of Pump Installer

Form: OLWR-SWR-1B

RECEIVED  
 MAR 24 2006  
 BY: OLWR