	State Well Report	
0.	· · · · · · · · · · · · · · · · · · ·	For Office Use Only:
County: Baivar	Part 1 – Driller's Log	
County: Della	Mississippi Department of Environmental Quality	Aquifer:
Permit 60042963	Office of Land and Water Resources	Well #: E - 112
V CL Seules	P.O. Box 10631	
Driller: Young's Custom Service	Jackson, MS 39289-0631	L. S. Elevation:
Date drilling completed: 2-12-08	(601)961-5210	
Date drifting completed.	(601)354-6938 (fax)	E-log #:

and the second

State Law requires that this report be prepared by the license holder responsible for the work and filed with the Department at the above address within 30 days of completion of drilling of the well or borehole.

Depuriment ut nie ubore mult coor	Well or Borehole Location				
Information on Well Owner (Landowner if boreliale is not for a water well)	9 42 59				
	Latitude: 33 . 54 . 18 " Longitude: 90 . 42 . 59 "				
Owner Name H+O Farms	Method of Lat/Long (circle one): Conventional Survey,				
Mailing Address: 124 hidge creat Lane					
Mailing Address: de la la reaction de la companya de la	USGS quad, Hand-held GPS Survey-grade GPS				
Clarksdale MS. 38614	Nw / NE 1/4 Sec 28 Twn 24 NRng SW				
City State Zip Code	Distance Direction Nearest Town				
Telephone No. (1012) 627 - 9428	Miles <u>easy</u> of <u>stielby</u>				
Telephone No. (1988) George					
Well / Bore	hole Data				
Date drilling started: 12/12 Date drilling completed: 12/12					
Location of the source of any surface water used for drilling:	tch				
Method of dosing and volume of Chlorine used in drilling and devel	lopment:				
Logs run (circle all applicable): No log run Electric Gamma Ray Name of organization running log(s):					
Purpose of borehole (check one): Water Well $\succeq$ Geotechnical/Geological Investigation Ground Source Heat Pump					
Seismic Survey Other (describe	)				
If drilling is not related to water well constructio	n, skip the remainder of this block				
Purpose of Well (check one): Home Industrial Public Supply Irrigation Fish Culture Other:					
If a flowing well, method of flow regulation: Valve Other (describe)					
Static Water Level:feet above or below (circle one) land surface Date measured:					
Method of Measurement (circle one) steel tape electric tape air line other:					
Well depth: 120 Well grouted to a depth offeet Type of grout (circle one): Neat Cement Bentonite Mix					
Casing length: <u>80</u> feet Casing diameter: <u>10</u> inches Type of casing: <u>RUL</u>					
Casing length: D Inches Type of casing.   Screen length: 40 feet Screen diameter: 0'' inches Type of screen: PUC					
Screen length: <u>40</u> feet Screen diameter: <u>10</u> inches Type of screen: <u>100</u>					
Screen slot size: 050 inches Setting depth: From 80 feet to 120 feet					
Type of completion (circle all applicable): Gravel packed Underreamed Telescoped Open hole Natural Development					
Other (describe):					
Top of lap pipe or reduction in casing:feet. If telescoped or more than one screen, describe on next page					
Form: OLWR-SWR-1A					


JAN 0 9 2009 BY: OLWR

E-172

6042963

The sketch below only required for water wells


If well telescopes, show depths on sketch.

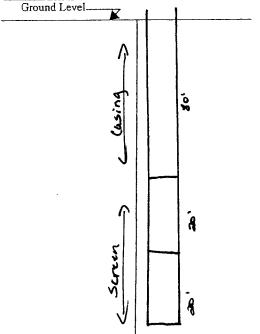

Description of formations encountered must be provided for all wells and boreholes, unless specifically exempted by regulations

Description of Formations Encountered	From (depth)	
Change	Ground Level	
Genes	2	65
Clar	0	15
Gumbo	15	40
Fine Sand	40	60
Gumbo Fine Sand Coarse Sand	60	120
······································		
· · · · · · · · · · · · · · · · · · ·		
	+	
	· · · · · · · · · · · · · · · · · · ·	

If more than one screen, show location of each on sketch

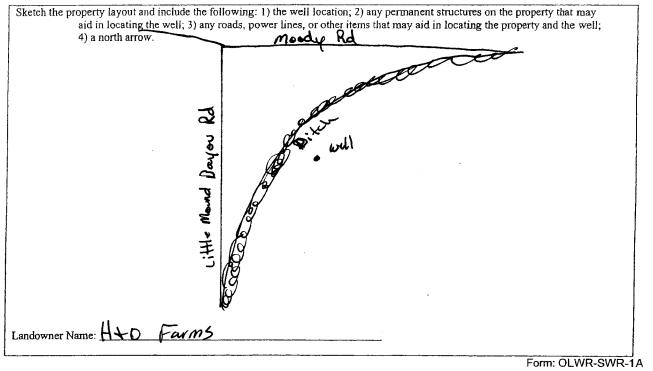

I certify that the well/borehole was drilled, constructed, and completed in accordance with all applicable requirements of the Mississippi Department of Environmental Quality and the Mississippi Department of Health regulations, if applicable, and state

laws. 00 Jumper

Print Name of Responsible Licensee and License No.

Date

Signature of Licensee

JAN 0 9 2009 BY: OLWR

	Part 2 Iler's Completion Report For Office Use Only:
	tment of Environmental Quality and and Water Resources
Driller: 100165 (USTOM Stourt P	P.O. Box 10631 on, MS 39289-0631 Well #: <u>E-172</u>
Date completed:	(601)961-5210
<u>Copy information from block on Part 1</u> (60	1)354-6938 (fax)
This part of the report must be completed by a licensed water w report must be attached and both parts filed with the Departme	well contractor or a licensed pump installer. A copy of Part 1 of the
Well Owner Information	Well Location
Owner Name: A+O Forms	Latitude: 33 54 18 Longitude: 90 42 59
Mailing Address: 124 Ridge Crest Lane	Method of Lat/Long (check one): Conventional Survey,
	USGS quad, Hand-held GPS 🗹, Survey-grade GPS
Clarksdale Ms. 38614	¼ ¼ Sec T R
City State Zip Code	Distance Direction Nearest Town
Telephone No. (462, 627 - 9428	10 Miles East of Shelby
Ритр Туре	Power Type
Circle one	Circle one
ir Lift Jet Submersible	Diesel Engine Gasoline Engine Natural Gas
Bucket Piston Farbine	Electric Motor Hand Tractor PTO
Centrifugal Rotary Flowing Well	Windmill Other (specify):
<b>,</b>	
Other (specify):	Horse Power Rating of Motor: 40
Dther (specify):	Horse Power Rating of Motor: <u>40</u> Setting Depth: <u>60</u> feet
Dther (specify):	Horse Power Rating of Motor: 40
Dther (specify):	Horse Power Rating of Motor: Setting Depth:feet Number of Stages: Method of Measuring Water Level
Dther (specify): Date Pump Installed: Rated Pump Capacity: Pump Test Data	Horse Power Rating of Motor: <u>40</u> Setting Depth: <u>60</u> feet Number of Stages: <u>2</u>
Dther (specify): Date Pump Installed: _l2[15 Rated Pump Capacity:Gallons Per Minute Pump Test Data Date Well Tested:2[15	Horse Power Rating of Motor: Setting Depth:feet Number of Stages: Method of Measuring Water Level
Dther (specify): Date Pump Installed: $2/5$ Rated Pump Capacity:Gallons Per Minute Pump Test Data Date Well Tested: $2/5$ Rateic Water Level (A):Feet Below Land Surface	Horse Power Rating of Motor: <u>40</u> Setting Depth: <u>60</u> feet Number of Stages: <u>2</u> Method of Measuring Water Level Circle one
Dther (specify): Date Pump Installed: $12/15$ Rated Pump Capacity:Gallons Per Minute Pump Test Data Date Well Tested: $12/15$ Static Water Level (A):Feet Below Land Surface rumping Water Level (B):Feet Below Land Surface	Horse Power Rating of Motor:
Other (specify): Date Pump Installed: $12/15$ Rated Pump Capacity:Gallons Per Minute Pump Test Data Date Well Tested: $12/15$ Static Water Level (A):Feet Below Land Surface rumping Water Level (B):Feet Below Land Surface Drawdown [(B) – (A)]:Feet Below Land Surface	Horse Power Rating of Motor: 40 Setting Depth: 60 feet Number of Stages: 2 Method of Measuring Water Level Circle one Air Line Electric Measuring Line Steel Tape Other (specify): for flowing well, measured shut in head: feet
Other (specify): Date Pump Installed: Rated Pump Capacity:Gallons Per Minute Pump Test Data Date Well Tested: Static Water Level (A): Feet Below Land Surface rumping Water Level (B): Feet Below Land Surface	Horse Power Rating of Motor:

• • • •

BY:	OL	WR
-----	----	----