

County: Bolivar  
 Permit #: GW-44617  
 Irrigation Equipment  
 Driller: \_\_\_\_\_  
 Date drilling completed: 10-11-10

**State Well Report**  
**Part 1 - Driller's Log**  
 Mississippi Department of Environmental Quality  
 Office of Land and Water Resources  
 P.O. Box 2309  
 Jackson, MS 39225  
 (601)961- 5210  
 (601)961- 5228 (fax)

**For Office Use Only:**  
 Aquifer: E 188  
 Well #: \_\_\_\_\_  
 L. S. Elevation: \_\_\_\_\_  
 E-log #: \_\_\_\_\_

*State Law requires that this report be prepared by the license holder responsible for the work and filed with the Department at the above address within 30 days of completion of drilling of the well or borehole.*

<p><b>Information on Well Owner</b>  <i>(Landowner if borehole is not for a water well)</i>          Owner Name: <u>Eugene Malatesta</u>          Mailing Address: <u>P.O. Box 347</u>  <u>Shelby</u> <u>Ms.</u> <u>38774</u>          City State Zip Code          Telephone No. ( ) _____</p>	<p><b>Well or Borehole Location</b>          Latitude: <u>33.55.11.3</u> Longitude: <u>90.41.39.3</u>          Method of Lat/Long (circle one): Conventional Survey,          USGS quad <u>Hand-held GPS</u> Survey-grade GPS  <u>NE 1/4 NE 1/4</u> Sec <u>22</u> Twn <u>24N</u> Rng <u>5W</u>          Distance Direction Nearest Town  <u>5</u> Miles <u>SE</u> of <u>Shelby</u></p>
---	--

**Well / Borehole Data**

Date drilling started: 10-11-10 Date drilling completed: 10-11-10 Hole depth: 121 Hole diameter: 20"  
 Location of the source of any surface water used for drilling: Surface Water  
 Method of dosing and volume of Chlorine used in drilling and development: 50 PPM  
 Logs run (circle all applicable): No log run Electric Gamma Ray Density Sonic Neutron Other: \_\_\_\_\_  
 Name of organization running log(s): \_\_\_\_\_  
 Purpose of borehole (check one): Water Well  Geotechnical/Geological Investigation \_\_\_\_\_ Ground Source Heat Pump \_\_\_\_\_  
 Seismic Survey \_\_\_\_\_ Other (describe) \_\_\_\_\_  
*If drilling is not related to water well construction, skip the remainder of this block*  
 Purpose of Well (check one): Home \_\_\_\_\_ Industrial \_\_\_\_\_ Public Supply \_\_\_\_\_ Irrigation  Fish Culture \_\_\_\_\_ Other: \_\_\_\_\_  
 If a flowing well, method of flow regulation: Valve \_\_\_\_\_ Other (describe) \_\_\_\_\_  
 Static Water Level: 41 feet above of below (circle one) land surface Date measured: 10-15-10  
 Method of Measurement (circle one) steel tape electric tape air line other: \_\_\_\_\_  
 Well depth: 121 Well grouted to a depth of 10 feet Type of grout (circle one): Neat Cement Bentonite Mix  
 Casing length: 81 feet Casing diameter: 12 inches Type of casing: PVC  
 Screen length: 40 feet Screen diameter: 12 inches Type of screen: PVC  
 Screen slot size: .050 inches Setting depth: From 82 feet to 121 feet  
 Type of completion (circle all applicable): Gravel packed Underreamed Telescoped Open hole Natural Development  
 Other (describe): \_\_\_\_\_  
 Top of lap pipe or reduction in casing: \_\_\_\_\_ feet. *If telescoped or more than one screen, describe on next page*

E788

The sketch below only required for water wells

If well telescopes, show depths on sketch.

Ground Level  $\xrightarrow{Z}$

Description of formations encountered must be provided for all wells and boreholes, unless specifically exempted by regulations

Description of Formations Encountered	From (depth)	To (depth)
Clay	Ground Level	29
Fine Sand	30	49
Fine Sand + Gravel	50	56
Medium Sand + Gravel	57	121

If more than one screen, show location of each on sketch

Sketch the property layout and include the following: 1) the well location; 2) any permanent structures on the property that may aid in locating the well; 3) any roads, power lines, or other items that may aid in locating the property and the well; 4) a north arrow.

Landowner Name: Eugene Malatesta

Form: OLWR-SWR-1A (04/08)

I certify that the well/borehole was drilled, constructed, and completed in accordance with all applicable requirements of the Mississippi Department of Environmental Quality and the Mississippi Department of Health regulations, if applicable, and state laws.

Patrick M Chism      0695

Print Name of Responsible Licensee and License No.

Date

Signature of Licensee

**STATE WELL REPORT**  
**Part 2**

**Pump Installer's Completion Report**  
Mississippi Department of Environmental Quality  
Office of Land and Water Resources  
P.O. Box 2309  
Jackson, MS 39225  
(601)961-5210  
(601)961-5228 (fax)

County: Bolivar  
 Permit #: GW-44617  
 Irrigation Equipment  
 Driller: \_\_\_\_\_  
 Date completed: 10-11-10  
 Copy information from block on Part 1

For Office Use Only:

Aquifer: \_\_\_\_\_  
 Well #: \_\_\_\_\_  
 Elevation: \_\_\_\_\_

*This part of the report must be completed by a licensed water well contractor or a licensed pump installer. A copy of Part 1 of the report must be attached and both parts filed with the Department at the above address within 30 days of well completion.*

Well Owner Information	Well Location
Owner Name: <u>Eugene Malatesta</u>	Latitude: _____ Longitude: _____
Mailing Address: <u>P.O. Box 347</u>	Method of Lat/Long (check one): Conventional Survey _____ USGS quad _____, Hand-held GPS <input checked="" type="checkbox"/> , Survey-grade GPS _____
<u>Shelby</u> Ms. <u>38774</u>	<u>NE</u> $\frac{1}{4}$ <u>NE</u> $\frac{1}{4}$ Sec <u>22</u> T <u>24N</u> R <u>5W</u>
City State Zip Code	Distance <u>5</u> Miles Direction <u>SE</u> of Nearest Town <u>Shelby</u>
Telephone No. ( ) _____	


Pump Type Circle one	Power Type Circle one
Air Lift <input type="checkbox"/> Jet <input type="checkbox"/> Submersible <input type="checkbox"/>	Diesel Engine <input type="checkbox"/> Gasoline Engine <input type="checkbox"/> Natural Gas <input type="checkbox"/>
Bucket <input type="checkbox"/> Piston <input type="checkbox"/> <b>Turbine</b> <input checked="" type="checkbox"/>	Electric Motor <input type="checkbox"/> Hand <input type="checkbox"/> Tractor PTO <input type="checkbox"/>
Centrifugal <input type="checkbox"/> Rotary <input type="checkbox"/> Flowing Well <input type="checkbox"/>	Windmill <input type="checkbox"/> Other (specify): _____
Other (specify): _____	Horse Power Rating of Motor: <u>30</u>
Date Pump Installed: <u>10-15-10</u>	Setting Depth: <u>70</u> feet
Rated Pump Capacity: <u>1400±</u> Gallons Per Minute	Number of Stages: <u>1</u>

Pump Test Data	Method of Measuring Water Level Circle one
Date Well Tested: _____	Air Line <input type="checkbox"/> Electric Measuring Line <input type="checkbox"/> Steel Tape <input type="checkbox"/>
Static Water Level (A): _____ Feet Below Land Surface	Other (specify): _____
Pumping Water Level (B): _____ Feet Below Land Surface	For flowing well, measured shut in head: _____ feet
Drawdown [(B) - (A)]: _____ Feet Below Land Surface	Well yielded _____ GPM with a drawdown of _____ feet after _____ hours of pumping
Test Pumping Rate: _____ Gallons Per Minute	
Duration of Pump Test (minimum 4 hours): _____ hours	

This is for (circle one):     New Well     Replacement of Existing Pump     Repair of Existing Pump

I HEREBY CERTIFY that the above statements are true to the best of my knowledge.

Patrick M Chism 0695 \_\_\_\_\_  
 Print Name of Pump Installer and License No. (if applicable)                                  Signature of Pump Installer

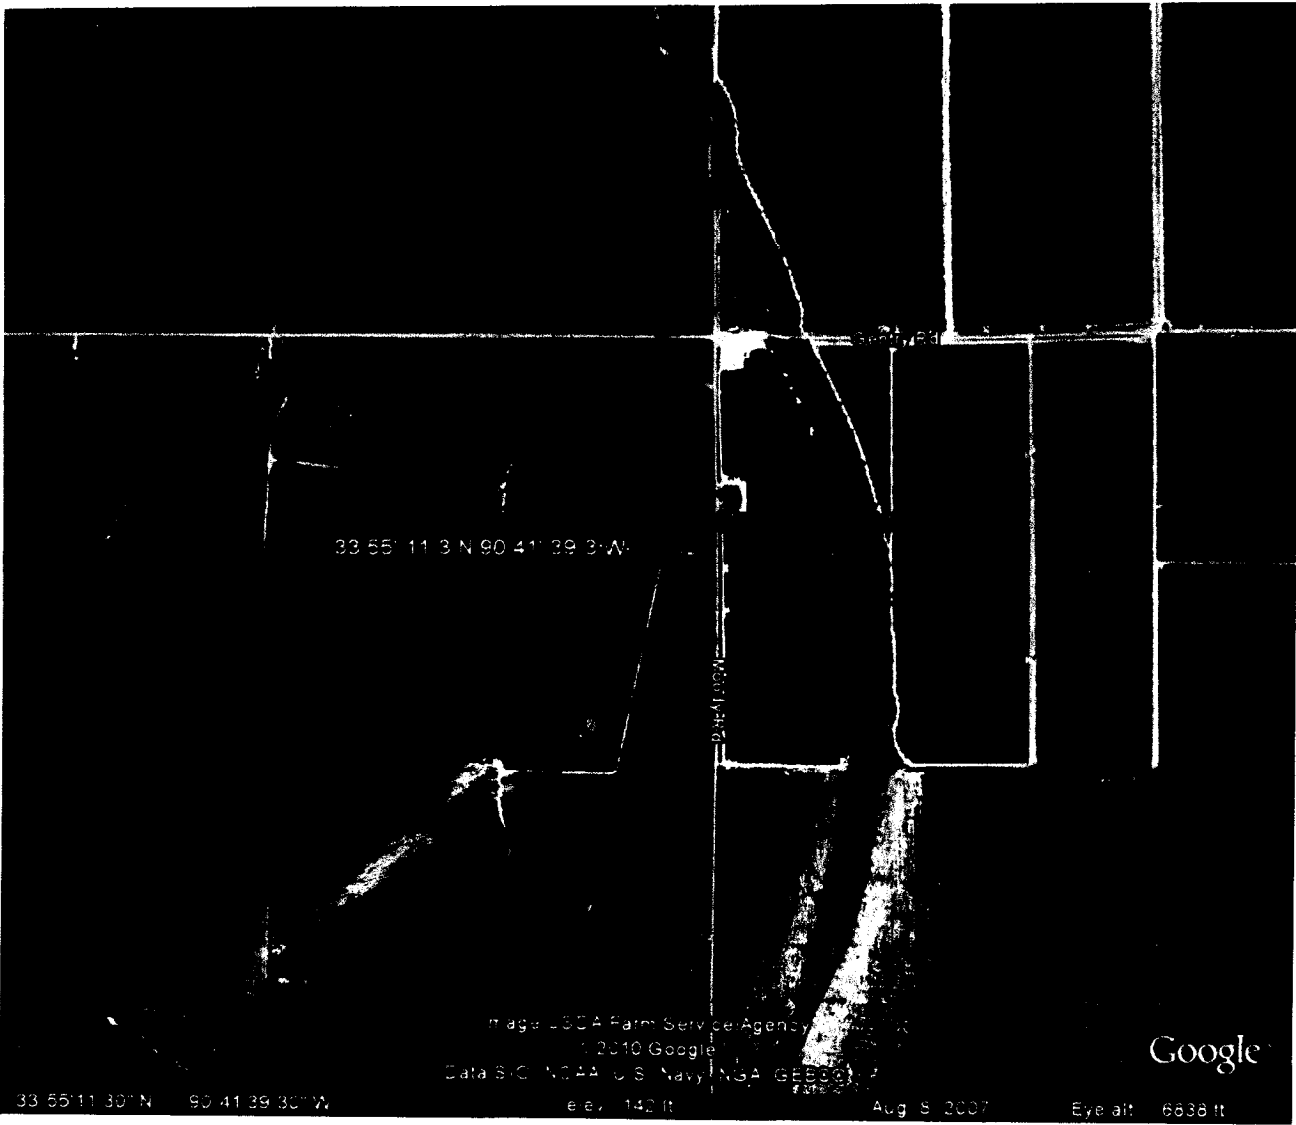

33 55' 11.3 N 90 41' 39.3 W

Image: USDA Farm Service Agency  
© 2010 Google

Data S/C: NOAA, U.S. Navy, NGA, GEBCO

Google

33 55' 11.30" N 90 41' 39.30" W

e lev: 140 ft

Aug 8, 2007

Eye alt: 6638 ft

RECEIVED  
EX-101  
EX-101