

County: Bolivar  
 Permit #: GW-44616  
 Irrigation Equipment  
 Driller:  
 Date drilling completed: 10-11-10

**State Well Report**  
**Part 1 - Driller's Log**  
 Mississippi Department of Environmental Quality  
 Office of Land and Water Resources  
 P.O. Box 2309  
 Jackson, MS 39225  
 (601)961- 5210  
 (601)961- 5228 (fax)

**For Office Use Only:**  
 Aquifer: E189  
 Well #: \_\_\_\_\_  
 L. S. Elevation: \_\_\_\_\_  
 E-log #: \_\_\_\_\_

*State Law requires that this report be prepared by the license holder responsible for the work and filed with the Department at the above address within 30 days of completion of drilling of the well or borehole.*

<p><b>Information on Well Owner</b>  <i>(Landowner if borehole is not for a water well)</i>          Owner Name: <u>Eugene Malatesta</u>          Mailing Address: <u>P.O. Box 347</u>  <u>Shelby</u> <u>Ms.</u> <u>38774</u>          City State Zip Code          Telephone No. ( ) _____</p>	<p><b>Well or Borehole Location</b>          Latitude: <u>33.56 15.2</u> Longitude: <u>90.44. 10.1</u>          Method of Lat/Long (circle one): Conventional Survey,          USGS quad, <u>Hand-held GPS</u>, Survey-grade GPS  <u>NW 1/4 NE 1/4</u> Sec. <u>17</u> Twn. <u>24N</u> Rng. <u>5W</u>          Distance Direction Nearest Town  <u>1</u> Miles <u>SE</u> of <u>Shelby</u></p>
---	--

**Well / Borehole Data**

Date drilling started: 10-11-10 Date drilling completed: 10-11-10 Hole depth: 122 Hole diameter: 20"

Location of the source of any surface water used for drilling: Surface Water  
 Method of dosing and volume of Chlorine used in drilling and development: 50 PPM

Logs run (circle all applicable): No log run Electric Gamma Ray Density Sonic Neutron Other: \_\_\_\_\_  
 Name of organization running log(s): \_\_\_\_\_

Purpose of borehole (check one): Water Well  Geotechnical/Geological Investigation  Ground Source Heat Pump   
 Seismic Survey  Other (describe) \_\_\_\_\_

*If drilling is not related to water well construction, skip the remainder of this block*

Purpose of Well (check one): Home  Industrial  Public Supply  Irrigation  Fish Culture  Other: \_\_\_\_\_

If a flowing well, method of flow regulation: Valve \_\_\_\_\_ Other (describe) \_\_\_\_\_

Static Water Level: 42 feet above or below (circle one) land surface Date measured: 10-15-10

Method of Measurement (circle one): steel tape electric tape air line other: \_\_\_\_\_

Well depth: 122 Well grouted to a depth of 10 feet Type of grout (circle one): Neat Cement Bentonite Mix

Casing length: 82 feet Casing diameter: 12 inches Type of casing: PVC

Screen length: 40 feet Screen diameter: 12 inches Type of screen: PVC


Screen slot size: .050 inches Setting depth: From 83 feet to 122 feet

Type of completion (circle all applicable): Gravel packed Underreamed Telescoped Open hole Natural Development  
 Other (describe): \_\_\_\_\_

Top of lap pipe or reduction in casing: \_\_\_\_\_ feet. *If telescoped or more than one screen, describe on next page*





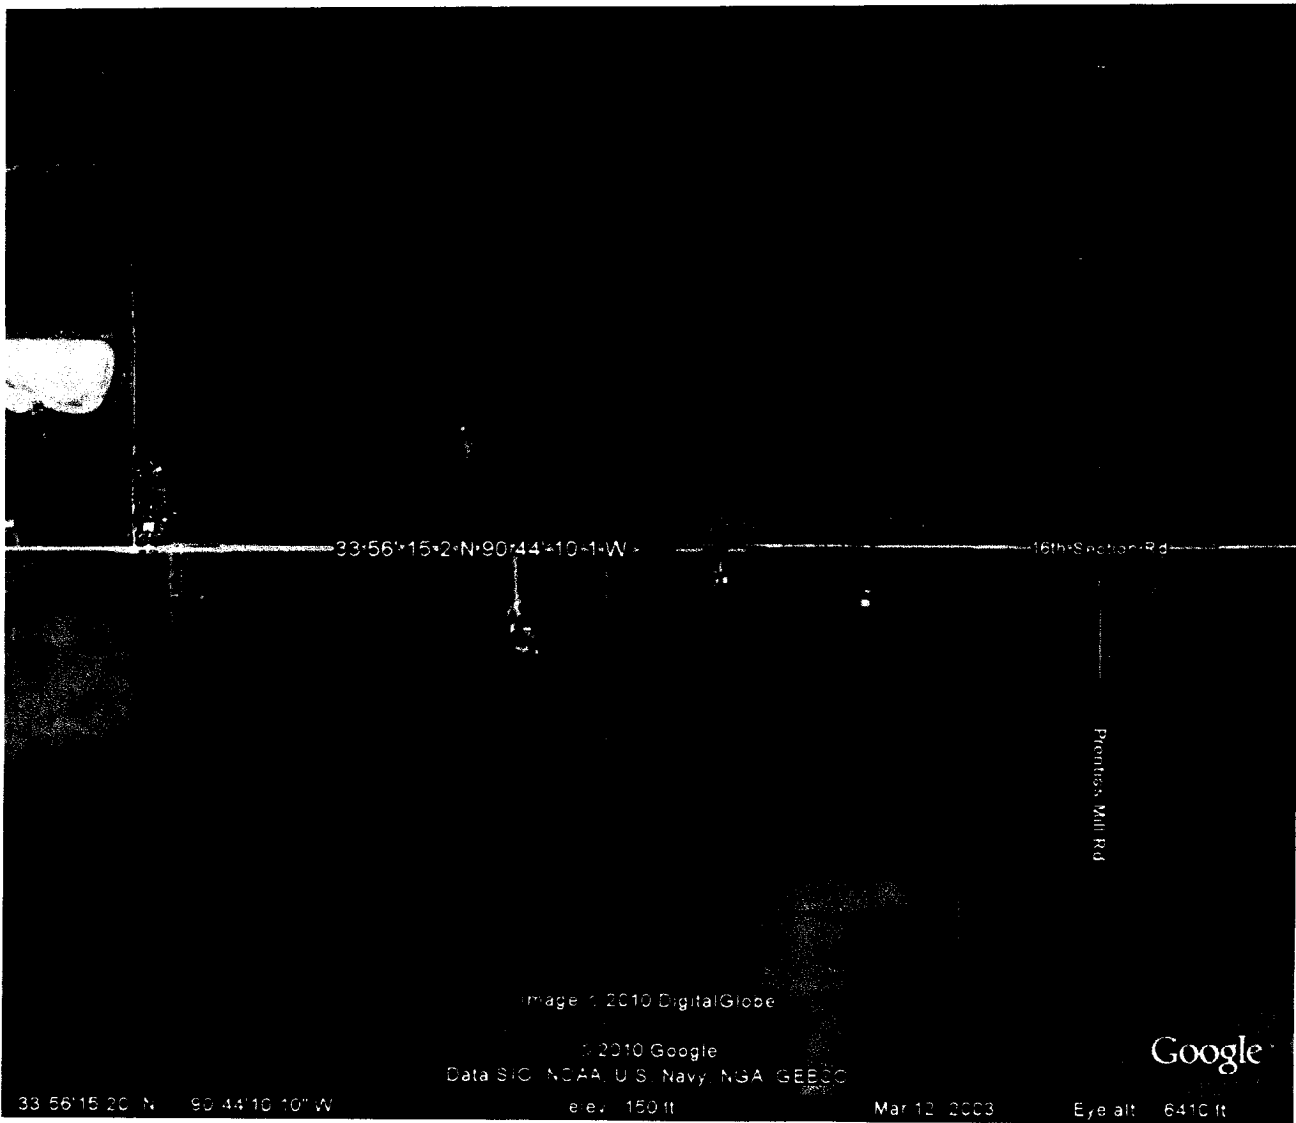

33°56'15.2"N 90°44'10.1"W

16th Section Rd

Prentiss Mill Rd

Image © 2010 DigitalGlobe

© 2010 Google

Data SIO, NOAA, U.S. Navy, NGA, GEBCO

Google

33°56'15.20" N 90°44'10.10" W

e.lev. 150 ft

Mar 12, 2003

Eye alt: 6410 ft

Handwritten notes in the bottom right corner, including the date '3/12/03' and some illegible text.