County:	Bolivar
Permit #.	GW-46724 /
Dnller:	Irrigation Equipment
Date drilli	ing completed: 04/26/2013

## **State Well Report**

Part 1 - Driller's Log

Mississippi Department of Environmental Quality Office of Land and Water Resources P.O. Box 2309 Jackson, MS 39225 (601) 961-5210 (601) 961-5228 (fax)

Fo	r Office Use Only:
Aquiter:	
Well #:	E200
L.S. Elevation:	
E-log #:	

State Law requires that this report be prepared by the license holder responsible for the work and filed with the Department at the above address within 30 days of completion of drilling of the well or borokele.

	Information on Well Owner	of completion of drilling of the well or borehole.		
(Landowner if borehole is not for a water well)		Well or Borehole Location		
Owner Name	Willie G. Malatesta	Latitude: 33 ° 54 ' 44 " Longitude: 90 ° 42 ' 15 "		
Mailing Address:	P.O. Box 213	Method of Lat/Long (check one): Conventional Survey,		
		☐ USGS quad, ☐ Hand-held GPS, ☐ Survey-grade GPS		
	Shelby Ms 38774	NW 1/4 SW 1/4 Sec 22 / Twn 24 N Rng 5 W		
	City State Zip code	Distance Direction Nearest Town		
Telephone No.	( ) -	2 Miles Northeast of Mound Bayou		
	Well / B	orehole Data		
Date drilling starte	ed: 04/26/2013 Date drilling completed: 04/2	26/2013 Hole depth: 127 Hole diameter: 24"		
Location of the so	urce of any surface water used for drilling: Surface			
	and volume of Chlorine used in drilling and developm			
Logs run (check all applicable):  No log run  Electric  Gamma Ray  Density  Sonic  Neutron  Other:  Name of organization running log(s):				
Purpose of borehole (check one): Water Well Geotechnical/Geological Investigation Ground Source Heat Pump				
Seismic Survey Other (describe)  If drilling is not related to water well construction, skip the remainder of this block				
Purpose of Well (check one) ☐ Home ☐ Industrial ☐ Public Supply ☒ Irrigation ☐ Fish Culture ☐ Other:				
If flowing, method of flow regulation: Valve Other (describe)				
Static Water Level: 43 feet above or below (check one) □ land ⊠ surface Date measured: 04/26/2013				
Method of Measurement (check one) ⊠ steel tape □ electric tape □ air line □ other:				
Well depth: 127 Well grouted to a depth of 10 feet Type of grout (check one): Neat Cement Bentonite Mix				
Casing length: 8	feet Casing diameter: 16	inches Type of casing: PVC		
Screen length: 40 feet Screen diameter: 16 inches Type of screen: PVC				
		.98 87 feet to 127 feet		
Type of completion (check all applicable):				
	Other (describe):	-		
Top of lap pipe or i	· · · · ·	telescoped or more than one screen, describe on next page		
		The same of the sa		

RECEIVED 8M70 78

MAY 07 2013

E102 7 0 YAM

BY: OLWR DANIED HWIO :YE

he sketch below only required	for water wells	Description of formations encount	ered must be provided for all	
f well telescopes, show depths	on sketch.	wells and boreholes, unless specifu	cally exempted by regulation	<u>i</u>
Ground level	and the second s	Description of Formations Encountered	From (depth)	To (dept
		Clay	Ground level	33
		Fine Sand	34	44
		Fine Sand & Gravel	45	60
		Medium Sand & Gravel	61	127
				ļ
				<u> </u>
				<b></b>
				ļ
		-		
				<del> </del>
				<del> </del>
				<b></b>
				ļ
				<b> </b>
				-
				<del> </del>
	en, show location of each on ske	L.		L
aid in	locating the well; 3) any rorth arrow.	ving: 1) the well location; 2) any permanent struct pads, power lines, or other items that may aid in loc	ating the property and t	may he well;
andowner Name:	Willie G. Malatesta			
rtify that the well/bo	rehole was drilled, construc	ed, and completed in accordance with all applicable r nd the Mississippi Department of Health regulations,	Form: OLWR-SM requirements of the	R-1A (04/

Print Name of Responsible Licensee and License No.

MAY 07 2013

**RECEIVED** 

BY: OLWR

## STATE WELL REPORT

## County. Bolivar Permit #: GW-46724 Driller: Irrigation Equipment Date drilling completed: 04/26/2013 Copy information from block on Part 1


## Part 2 **Pump Installer's Completion Report**

Mississippi Department of Environmental Quality Office of Land and Water Resources P.O. Box 2309 Jackson, MS 39225 (601) 961-5210 (601) 961-5228 (fax)

For Office Use Only:		
Aquifer:		
Well #:	Eadd	
Elevation .		

This part of the report must be completed by a licensed water well contractor or a licensed pump installer. A copy of Part 1 of the report must be attached and both parts filed with the Department at the above address within 30 days of well completion.				
Well Owner Information	Well Location			
Owner Name: Willie G. Malatesta	Latitude: 33 54' 44.0 N Longitude: 90 42' 15.0 W			
Mailing Address: P.O. Box 213	Method of Lat/Long (check one): Conventional Survey,			
	☐ USGS quad, ☒ Hand-held GPS, ☐ Survey-grade GPS			
Shelby Ms 38774	NW 1/4 SW 1/4 Sec 22 T 24 N R 5 W			
City State Zip code	Distance Direction Nearest Town			
Telephone No. ( ) -				
respirate No.	2 Miles Northeast of Mound Bayou			
Pump Type	Power Type			
Check one	Check one			
☐ Air Lift ☐ Jet ☐ Submersible	☐ Diesel Engine ☐ Gasoline Engine ☐ Natural Gas			
☐ Bucket ☐ Piston ☐ Turbine	☐ Electric Motor ☐ Hand ☐ Tractor PTO			
☐ Centrifugal ☐ Rotary ☐ Flowing Well	☐ Windmill ☐ Other (specify):			
Other (specify):	Horse Power Rating of Motor: 60			
Date Pump Installed:	Setting Depth: 70 feet			
Rated Pump Capacity 2500+/- Gallons Per Minute	Number of Stages: 1			
Pump Test Data	Method of Measuring Water Level			
	Check one			
Date Well Tested:	☐ Air Line ☐ Electric Measuring Line ☐ Steel Tape			
Static Water Level (A): Feet Below Land Surface	Other (specify):			
Pumping Water Level (B): Feet Below Land Surface				
Drawdown [(B) - (A)]: Feet Below Land Surface	For flowing well, measured shut in head: feet			
Test Pumping Rate: Gallons Per Minute	Well yielded GPM with a drawdown of			
Duration of Pump Test (minimum 4 hours): hours	feet after hours of pumping			
This is for (check one): New Well Replacement of Existing Pump Repair of Existing Pump				
I HEREBY CERTIFY that the above statements are true to the best of my knowledge				
Patrick Chism 0695	RECEIVED			
Print Name of Pump Installer and License No. (if applicable)	Signature of Pump Installer MAY 0 7 2013			

BY: OLWR

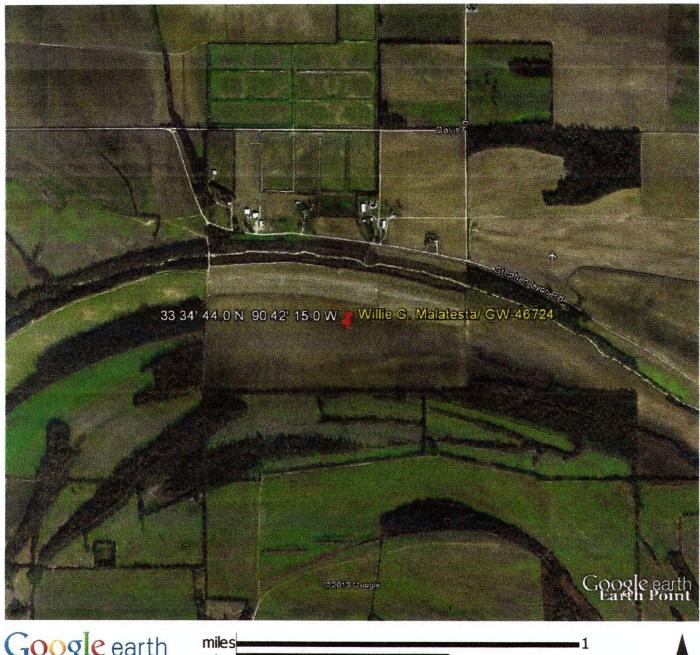

Google earth

RECEIVED

MAY 07 2013

BY: OLWR