

STATE WELL REPORT

Part 1

Driller's Log

Mississippi Department of Environmental Quality
Office of Land and Water Resources

P.O. Box 2309
Jackson, MS 39225-2309
(601)961-5210
(601)360-0535 (fax)

For Office Use Only:

Well #: E 211
Aquifer: _____
E-Log #: _____

County: Bolivar
Permit #: GW-48090
Driller: Willie Bryant
Date drilling completed: 5-3-14

State Law requires that this report be prepared by the license holder responsible for the work and filed with the Department at the above address within 30 days of completion of drilling of the well or borehole.

Well Owner Information <small>(Landowner if borehole is not for a water well)</small>	Well or Borehole Location
Owner Name: <u>Daryl Grant</u>	Latitude: <u>33°54'30.72" N</u> Longitude: <u>90°42'35.11" W</u>
Mailing Address: <u>P.O. Box 243</u>	Method of Lat/Long (check one): Conventional Survey _____
<u>Shelby</u> <u>MS</u> <u>38774</u>	USGS quad _____ Hand-held GPS <input checked="" type="checkbox"/> Survey-grade GPS _____
City State Zip Code	<u>SW</u> <u>NW</u> <u>SW</u> <u>NW</u> 1/4, Sec <u>22</u> ²⁷ T <u>24</u> N R <u>5</u> W
Telephone No. <u>(662) 515-3577</u>	<u>5</u> Miles <u>SE</u> of <u>Shelby</u>
	(Distance) (Direction) (Nearest Town)

Well / Borehole Data
Date drilling started: <u>5-3-14</u> Date drilling completed: <u>5-3-14</u> Hole depth: <u>120'</u> Hole diameter: <u>12 3/4"</u>
Location of the source of any surface water used for drilling: <u>Nearby ditch</u>
Method of dosing and volume of Chlorine used in drilling and development: <u>- 0 -</u>
Logs run (circle all applicable): <input checked="" type="checkbox"/> No log run <input type="checkbox"/> Electric <input type="checkbox"/> Gamma Ray <input type="checkbox"/> Density <input type="checkbox"/> Sonic <input type="checkbox"/> Neutron <input type="checkbox"/> Other: _____
Name of organization running log(s): _____
Purpose of borehole (circle one): <input checked="" type="checkbox"/> Water Well <input type="checkbox"/> Geotechnical/Geological Investigation <input type="checkbox"/> Ground Source Heat Pump
<input type="checkbox"/> Seismic Survey <input type="checkbox"/> Other (describe) _____
<i>If drilling is not related to water well construction, skip the remainder of this block</i>
Purpose of Well (circle all applicable): Home <input type="checkbox"/> Industrial <input type="checkbox"/> Public Supply <input checked="" type="checkbox"/> Irrigation <input type="checkbox"/> Fish Culture
Other (describe): _____
If a flowing well, method of flow regulation: Valve _____ Other (describe) _____
Static Water Level: <u>43</u> feet [above or <input checked="" type="checkbox"/> below] land surface Date measured: <u>5-6-14</u>
Method of measurement (circle one): Steel tape <input type="checkbox"/> Electric tape <input type="checkbox"/> Air line <input type="checkbox"/> Other (describe): <u>Sonic water level meter</u>
Well depth: <u>120'</u> Well grouted to a depth of: <u>12</u> feet Type of grout (circle one): Neat Cement <input type="checkbox"/> <input checked="" type="checkbox"/> Bentonite <input type="checkbox"/> Mix
Casing length: <u>80</u> feet Casing diameter: <u>6</u> inches Type of casing: <u>PVC</u>
Screen length: <u>40</u> feet Screen diameter: <u>6</u> inches Type of screen: <u>PVC slotted</u>
Screen slot size: <u>.032</u> inches Setting depth: From <u>80</u> feet to <u>120</u> feet
Type of completion (circle all applicable): <input checked="" type="checkbox"/> Gravel packed <input type="checkbox"/> Underreamed <input type="checkbox"/> Open hole <input type="checkbox"/> Natural Development
Other (describe): _____
Top of lap pipe or reduction in casing: <u>- 0 -</u> feet
<i>If telescoped or more than one screen, describe on next page</i>

RECEIVED

STATE WELL REPORT

Part 2

Pump Installer's Completion Report
 Mississippi Department of Environmental Quality
 Office of Land and Water Resources
 P.O. Box 2309
 Jackson, MS 39225-2309
 (601)961-5210
 (601) 360-0535 (fax)

For Office Use Only:

Well #: E211
 Aquifer: _____

County: bolivar
 Permit #: GW-48090
 Driller: Willie Bryant
 Date completed: 5-10-14
Copy information from block on Part 1

This part of the report must be completed by a licensed water well contractor or a licensed pump installer. A copy of Part 1 of the report must be attached and both parts filed with the Department at the above address within 30 days of well completion.

Well Owner Information	Well Location
Owner Name: <u>Daryl Grant</u>	Latitude: <u>33°54'30.72" N</u> Longitude: <u>90°42'35.11" W</u>
Mailing Address: <u>P.O. Box 243</u>	Method of Lat/Long (check one): Conventional Survey _____
City: <u>shelby</u> State: <u>ms</u> Zip Code: <u>38774</u>	USGS quad _____, Hand-held GPS <input checked="" type="checkbox"/> , Survey-grade GPS _____
Telephone No. <u>(662) 515-3577</u>	<u>SW</u> ^{NW} <u>SW</u> ^{SW} <u>SE</u> ^{SE} Sec <u>22</u> ²⁷ T <u>24</u> ^N R <u>5</u> ^W
	<u>5</u> Miles <u>SE</u> of <u>shelby</u> (Distance) (Direction) (Nearest Town)

Pump Type (circle one)

Submersible Turbine Air Lift Centrifugal Flowing Well Jet Piston Rotary Other (describe): _____

Date Pump Installed: 5-10-14 Rated Pump Capacity: 450 Gallons Per Minute

Is This Pump (circle one): New Repaired Replacement

Power Type (circle one)

Electric Diesel Gasoline Natural Gas Tractor PTO Windmill Other (describe): _____

Horse Power Rating of Motor: 10 Setting Depth: 80' feet Number of Stages: 2

Pump Test Data for Non Flowing Well

Date Well Tested: _____ Duration of Pump Test (minimum 4 hours): _____ hours

Static Water Level (A): _____ Feet Below Land Surface Pumping Water Level (B): _____ Feet Below Land Surface

Drawdown [(B) - (A)]: _____ Feet Below Land Surface Test Pumping Rate: _____ Gallons Per Minute

Method of measurement (circle one): Steel tape Electric tape Air line Other (describe): _____

Pump Test Data for Flowing Well

Measured shut in head: _____ feet.

Well yielded _____ GPM with a drawdown of _____ feet after _____ hours of pumping

Meter Installation

Meter Manufacturer: McCrometer Meter Serial Number: 14-01337

Meter Model Number/Name: M0306 Type of Meter: propeller

Totalizer Register Unit and Multiplier Factor (AF x .001, gal x 1000, etc): _____

Installation Date: 5-10-14 Meter installed by: Bryant Well & Pump Ser. - Willie Bryant


Is This Meter (circle one): New Repaired Replacement

Important: By submitting the above information you are certifying that this meter was installed to manufacturer standards. For agricultural wells, a list of approved meters is on the MDEQ website.

I HEREBY CERTIFY that the above statements are true to the best of my knowledge.

Willie L. Bryant 0-639 5-14-14 Willie L. Bryant
 Print Name of Pump Installer and License No. (if applicable) Date Signature of Pump Installer

E 211

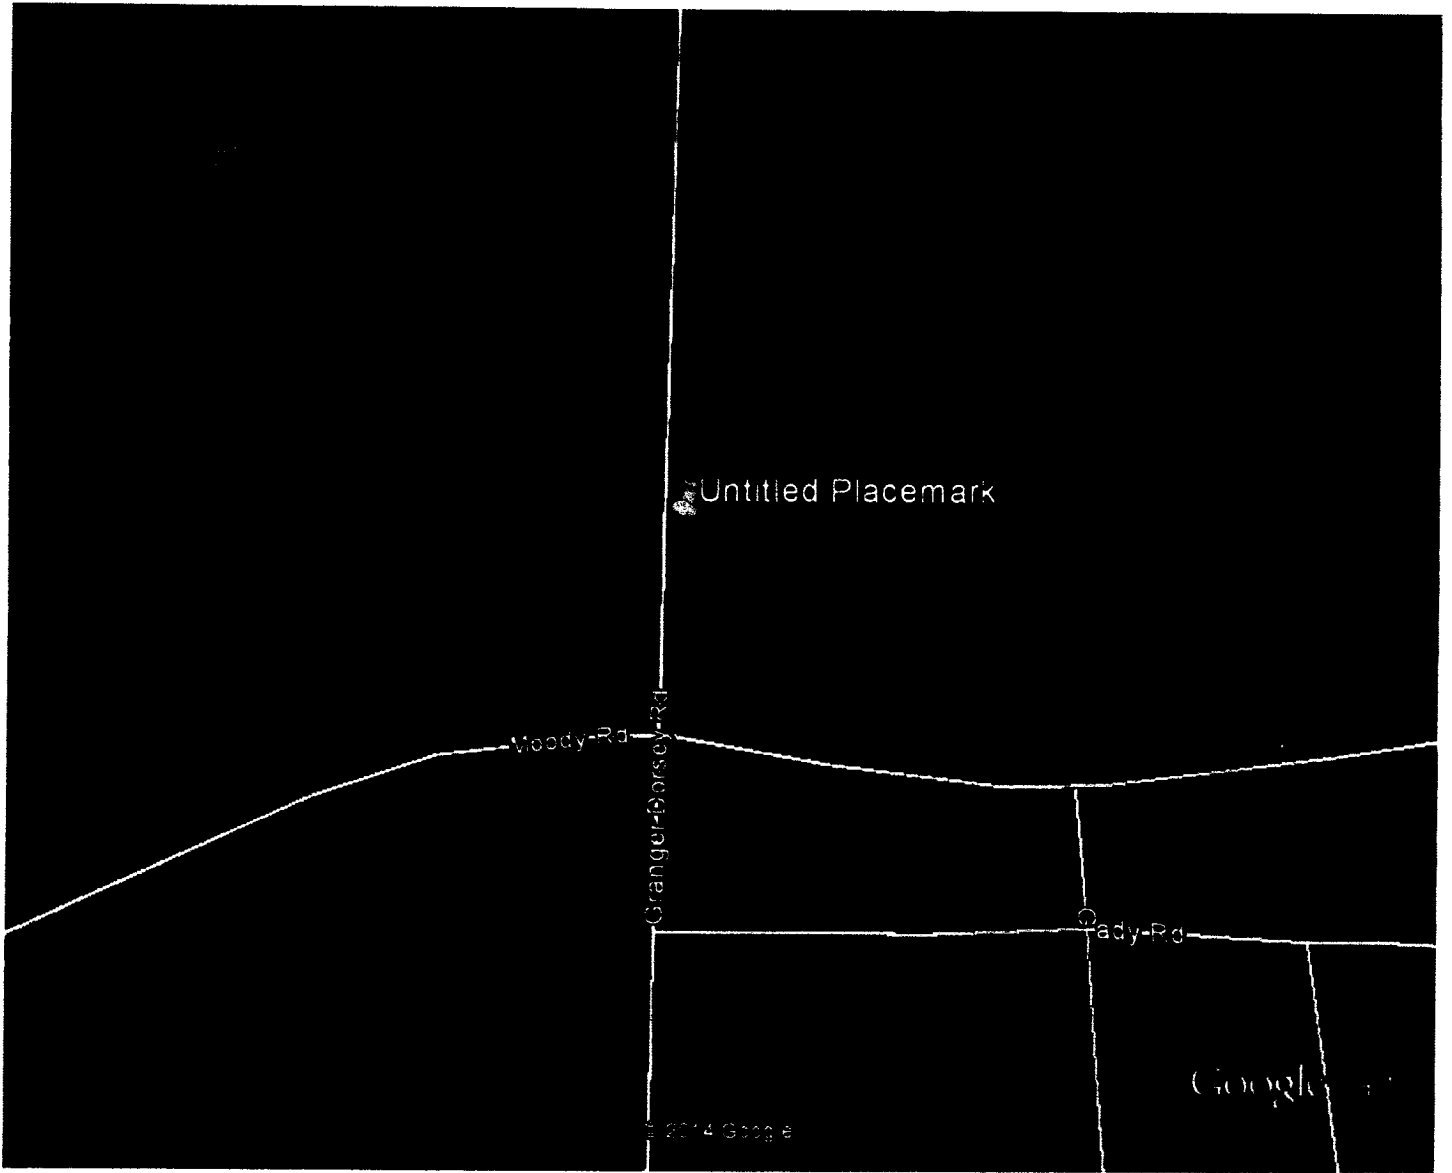

Google earth

