County:	Bolivar			
Permit #:	GW-47888			
Driller: Irrigation Equipment				
Date drilli	ng completed:	07/10/2014		

STATE WELL REPORT

Part 1

Driller's Log
Mississippi Department of Environmental Quality
Office of Land and Water Resources P.O. Box 2309 Jackson, MS 39225-2309 (601) 961-5210

For Office Use Only: Well#: <u>EQ15</u> Aquifer: E-Log #:

(601)	360-0535 (fax)				
State Law requires that this report be prepared by the lie					
Department at the above address within 30 days of com Well Owner Information	pletion of drilling of the well or borehole. Well or Borehole Location				
(Landowner if borehole is not for a water well)	THEIR OF BOTCHOIC ESCATION				
Owner Name: American Farm Group	Latitude: 33 56' 55.4 N Longitude: 90 40' 15.3 W				
Mailing Address: P.O. Box 104	Method of Lat/Long (check one): Conventional Survey,				
	☐ USGS quad, ☑ Hand-held GPS, ☐ Survey-grade GPS				
Inverness Ms 38753	SE 1/4 NW 1/4, Sec 12 T 24 N R 5 W				
City State Zip code					
Telephone No	5 Miles East of Shelby (Distance) (Direction) (Nearest Town)				
Well / Bo	rehole Data				
Date drilling started: 07/10/2014 Date drilling completed:	07/10/2014 Hole depth: 109' Hole diameter: 24"				
Location of the source of any surface water used for drilling:	Surface Water				
Method of dosing and volume of Chlorine used in drilling and dev	elopment: 50 PPM				
Logs run (check all applicable): ⊠ No log run ☐ Electric ☐ Gam	nma Ray				
Name of organization running log(s):					
	_				
Purpose of borehole (check one): Water Well Geotech	nnical/Geological Investigation				
☐ Seismic Survey	Other (describe)				
If drilling is not related to water well con	nstruction, skip the remainder of this block				
Purpose of Well (check all applicable): ☐ Home ☐ Industrial ☐ F	Public Supply ☑ Irrigation ☐ Fish Culture				
Other (describe):					
If a flowing well, method of flow regulation: Valve					
Static Water Level: 42' feet [□ above or ⋈ below] land surface Date measured: 07/14/2014 (check one)					
Method of Measurement (check one) \boxtimes Steel tape \square Electric tape	pe Air line Other: (describe)				
Well depth: 109' Well grouted to a depth of: 10' fee	t Type of grout (check one): ☐ Neat Cement ☑ Bentonite ☐ Mix				
Casing length: 69' feet Casing diameter: 16"	inches Type of casing: PVC				
Screen length: 40' feet Screen diameter: 16"	inches Type of screen: PVC				
Screen slot size:050 inches Setting depth:	From <u>70'</u> feet to <u>109'</u> feet				
Type of completion (check all applicable): ☑ Gravel packed ☐ U					
Other (describe):	W 2 2 (0)-				
Top of lap pipe or reduction in casing: Feet					
If telescoped or more than one screen, describe on next page					

Form: OLWR-SWR-1A (4/13)

County: Bolivar Permit #: GW-47888 The sketch below only required for water wells If well telescopes, show depths on sketch. Ground level Description of formations encountere and boreholes, unless specifically exe Clay Fine Sand Fine Sand & Gravel Medium Sand & Gravel Clay Clay Medium Sand & Gravel Clay	mpted by regulations
Permit #: GW-47888 The sketch below only required for water wells If well telescopes, show depths on sketch. Ground level Clay Fine Sand Fine Sand & Gravel Medium Sand & Gravel	d must be provided for all wells mpted by regulations ered From (depth) To (depth) Ground level 33 34 38 39 54 55 106
Description of formations encountere and boreholes, unless specifically executed for water wells Ground level Clay Fine Sand Fine Sand & Gravel Medium Sand & Gravel	To (depth) To (depth) Ground level 33 34 38 39 54 55 106
Ground level Clay Fine Sand & Gravel Medium Sand & Gravel	To (depth) To (depth) Ground level 33 34 38 39 54 55 106
Ground level Ground level Ground level Fine Sand Fine Sand & Gravel Medium Sand & Gravel	To (depth) To (depth) Ground level 33 34 38 39 54 55 106
Description of Formations Encounted Clay Fine Sand Fine Sand & Gravel Medium Sand & Gravel	From (depth) To (depth) Ground level 33 34 38 39 54 55 106
Description of Formations Encounted Clay Fine Sand Fine Sand & Gravel Medium Sand & Gravel	Ground level 33 34 38 39 54 55 106
Fine Sand & Gravel Medium Sand & Gravel	Ground level 33 34 38 39 54 55 106
Fine Sand & Gravel Medium Sand & Gravel	39 54 55 106
Medium Sand & Gravel	55 106
Clay	107 109
	1
,	
f more than one screen, show location of each on sketch	
Sketch the property layout and include the following: 1) the well location 2) any permanent structures on the property that may aid in locating the well 3) any roads, power lines, or other items that may aid in locating the property and the well 4) a north arrow	
	RECEIVE 101 2 8 2014
.andowner Name: American Farm Group	
HEREBY CERTIFY that the well/borehole was drilled, constructed, and completed in accordance	Form: OLWR-SWR-1A (04/08

07/23/2014

Date

Signature of Licensee Form: OLWR-SWR-1A (4/13)

Patrick Chism

0695

Print Name of Responsible Licensee and License No.

County:	Bolivar	
Permit #:	GW-47888	
Driller:	Irrigation Eq	uipment
Date drill	ing completed:	07/10/2014
	•	m block on Part 1

STATE WELL REPORT Part 2


Pump Installer's Completion Report
Mississippi Department of Environmental Quality
Office of Land and Water Resources
P.O. Box 2309 Jackson, MS 39225-2309 (601) 961-5210 (601) 360-0535 (fax)

For	Office Use Only:
Well #:	<u>E215</u>
Aquifer:	

This part of the report must be completed by a licensed water well contractor or a licensed pump installer. A copy of Part 1 of the report must be attached and both parts filed with the Department at the above address within 30 days of well completion.					
oj ine report mus	Well Owner Information		irinesa ai ine above adai	Well Location	wea completion.
Owner Name: A	merican Farm Group		Latitude: 33 56' 55.	4 N Longitude:	90 40' 15.3 W
Mailing Address:	P.O. Box 104		Method of Lat/Long (c	heck one): 🔲 Con	ventional Survey,
	☐ USGS quad, ☑ Hand-held GPS, ☐ Survey-grade GPS				
Inverness City	Ms State	38753 Zip code	<u>SE</u> % <u>N</u>	<u>W</u> ¼, Sec <u>12</u> ⊤ <u>24 N</u>	R <u>5 W</u>
Telephone No.			5 Miles _	East of	Shelby (Nearest Town)
		Pump Typ	e (check one)		
☐ Submersible ⊠	Turbine ☐ Air Lift ☐ Cent			otary □ Other (descr	ibe):
Date Pump Installe		•	Rated Pump Capacity:	•	
! · · · · · · · · · · · · · · · · · · ·	ck one): ⊠ New ☐ Repair	ed Replacement			
	•	Power Typ	e (check one)		
☐ Electric ☑ Dies	el 🗌 Gasoline 🗌 Natural (Gas 🗌 Tractor PTO	☐ Windmill ☐ Other (de	scribe):	
Horse Power Ratir	ng of Motor: 40	Setting Depth:	70 1	eet Number of Stag	es: <u>2</u>
		Dames Total Data 6	an Alam Plansin m Mall		
Data Mall Tankadı		•	or Non Flowing Well	(minimum 4 house):	Hauma
Date Well Tested:			Duration of Pump Test	•	
	(A): Feet B			·	1
Drawdown [(B) - (A)]: Feet Below Land Surface Test Pumping Rate: Gallons Per Minute Method of measurement (check one): _ Steel tape _ Electric tape _ Air line _ Other (describe):					
Method of measur	ement (check one): Li Stee			escribe).	
Pump Test Data for Flowing Well					
Measured shut in i	head: Fe	eet			
Well yielded	GPM with a dra	awdown of	feet after	ho	urs of pumping
Meter Installation					
Meter Manufacture	er:		Meter Serial Numb	er:	
Meter Model Numl	ber/Name:		Type of Meter: _		
Totalizer Register Unit and Multiplier Factor (AF x .001, gal x 1000, etc):					
Installation Date: Meter installed by:					
Is This Meter (check one): New Repaired Replacement					
Important: By submitting the above information you are certifying that this meter was installed to manufacturer standards. For agricultural wells, a list of approved meters is on the MDEQ medsite.					
I HEREBY CERTIFY that the above statements are true to the best of my knowledge.					
Patrick Chism	0695		07/23/2014	_ \0	2
Print Name of P	ump Installer and License	No. <i>(if applicable)</i>	Date	* Signature of	of Pump Installer

Paum musiciales bio Pauma Om & Diale -044-040-0400 - Fauma Om & Diale -aum

Form: OLWR-SWR-1B (4/13)

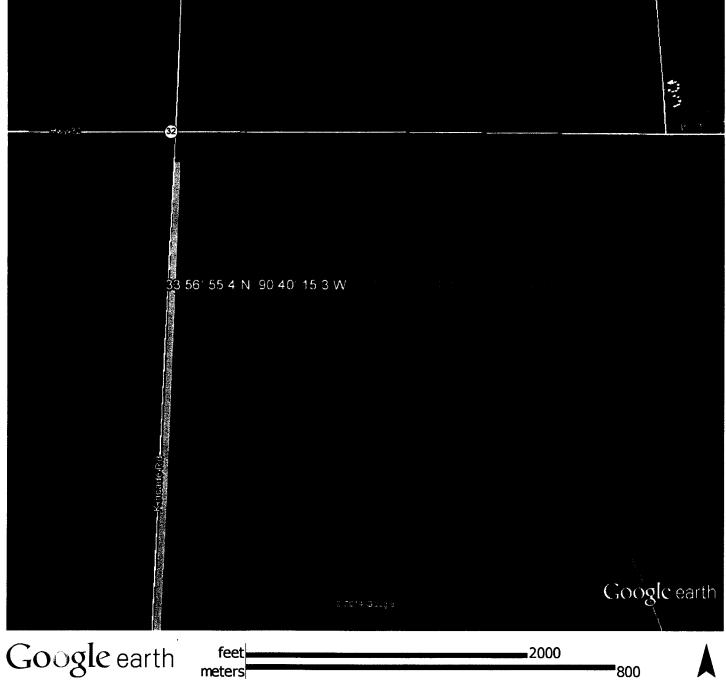

feet meters 800