

County: Bolivar
Permit #: GW-44407 ✓
Driller: Irrigation Equipment
Date drilling completed: 03/19/2014

STATE WELL REPORT
Part 1
Driller's Log
Mississippi Department of Environmental Quality
Office of Land and Water Resources
P.O. Box 2309
Jackson, MS 39225-2309
(601) 961-5210
(601) 360-0535 (fax)

For Office Use Only:
Well #: E216
Aquifer: _____
E-Log #: _____

State Law requires that this report be prepared by the license holder responsible for the work and filed with the Department at the above address within 30 days of completion of drilling of the well or borehole.

Well Owner Information <i>(Landowner if borehole is not for a water well)</i>			Well or Borehole Location	
Owner Name: <u>Pongetti Farms Partnership</u>			Latitude: <u>33 55' 24.6 N</u>	Longitude: <u>90 44' 42.0 W</u>
Mailing Address: <u>45 Harden Drive</u>			Method of Lat/Long (check one): <input type="checkbox"/> Conventional Survey,	
			<input type="checkbox"/> USGS quad, <input checked="" type="checkbox"/> Hand-held GPS, <input type="checkbox"/> Survey-grade GPS	
			<u>SW 1/4 SW 1/4, Sec 17 T 24 N R 5 W</u>	
<u>Merigold</u> City	<u>Ms</u> State	<u>38759</u> Zip code		
Telephone No. <u>() -</u>			<u>2</u> Miles <u>Southeast</u> of <u>Shelby</u> <i>(Distance) (Direction) (Nearest Town)</i>	

Well / Borehole Data

Date drilling started: 03/19/2014 Date drilling completed: 03/19/2014 Hole depth: 125' Hole diameter: 24"

Location of the source of any surface water used for drilling: Surface Water

Method of dosing and volume of Chlorine used in drilling and development: 50 PPM

Logs run (check all applicable): No log run Electric Gamma Ray Density Sonic Neutron Other: _____

Name of organization running log(s): _____

Purpose of borehole (check one): Water Well Geotechnical/Geological Investigation Ground Source Heat Pump
 Seismic Survey Other (describe) _____

If drilling is not related to water well construction, skip the remainder of this block

Purpose of Well (check all applicable): Home Industrial Public Supply Irrigation Fish Culture
 Other (describe): _____

If a flowing well, method of flow regulation: Valve _____ Other (describe) _____

Static Water Level: 46' feet [above or below] land surface Date measured: 03/20/2014
(check one)

Method of Measurement (check one) Steel tape Electric tape Air line Other: (describe) _____

Well depth: 125' Well grouted to a depth of: 10' feet Type of grout (check one): Neat Cement Bentonite Mix

Casing length: 85' feet Casing diameter: 16 inches Type of casing: PVC

Screen length: 40' feet Screen diameter: 16 inches Type of screen: PVC

Screen slot size: .050 inches Setting depth: From 86' feet to 125' feet

Type of completion (check all applicable): Gravel packed Underreamed Open hole Natural Development
 Other (describe): _____

Top of lap pipe or reduction in casing: _____ Feet


If telescoped or more than one screen, describe on next page

Form: OLWR-SWR-1A (4/13)

RECEIVED

APR 29 2014

BY OLWR

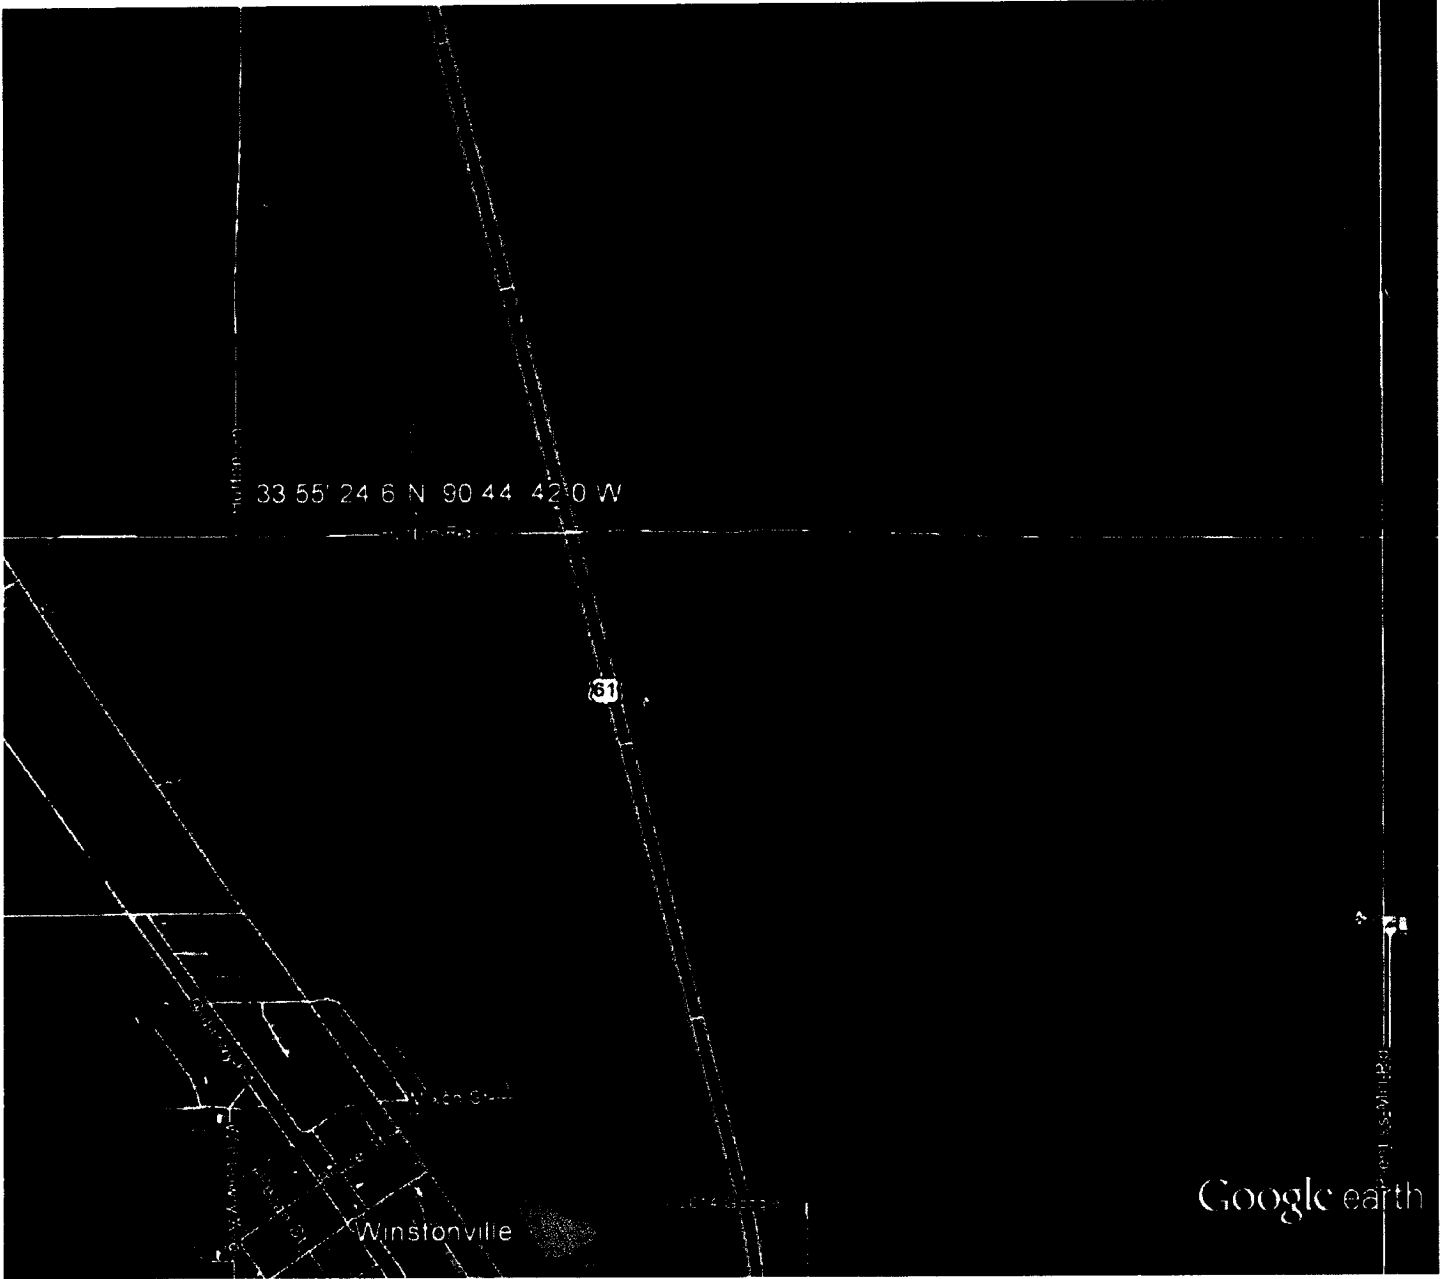

Google earth



RECEIVED
 APR 20 2012
 BY OLIVE