County:	Bolivar	
Permit #:	GW-46725	1
Driller:	Irrigation Eq	uipment
Date drilli	ng completed:	07/11/2013

## STATE WELL REPORT

## Part 1

Driller's Log
Mississippi Department of Environmental Quality
Office of Land and Water Resources P.O. Box 2309 Jackson, MS 39225-2309

(601) 961-5210 (601) 360-0535 (fax)

For Office Use Only:	
Well#: E 217	
Aquifer:	
E-Log #:	

State Law requires that this report be prepared by the license holder responsible for the work and filed with the

Department at the above address within 30 days of comp	pletion of drilling of the well or borehole.
Well Owner Information (Landowner if borehole is not for a water well)	Well or Borehole Location
Comman Marris II	Latitude: 33 55' 25.6 N Longitude: 90 40' 47.3 W
	Latitude. 33 33 23.0 14 Longitude. 30 40 47.3 14
Mailing Address: 508 Westover Drive	Method of Lat/Long (check one): ☐ Conventional Survey,
	☐ USGS quad, ☑ Hand-held GPS, ☐ Survey-grade GPS
Clarksdale Ms 38614	SE 1/4 SE 1/4, Sec 14 T 24 N R 5 W
City State Zip code	
Telephone No	5 Miles Southeast of Shelby (Distance) (Direction) (Nearest Town)
Well / Bor	rehole Data
Date drilling started: 07/11/2013 Date drilling completed:	07/11/2013 Hole depth: 126 Hole diameter: 18"
Location of the source of any surface water used for drilling:S	urface Water
Method of dosing and volume of Chlorine used in drilling and deve	elopment: 50 PPM
Logs run (check all applicable): ☑ No log run ☐ Electric ☐ Gam	ma Ray 🗌 Density 🗎 Sonic 🗎 Neutron 🗎 Other:
Name of organization running log(s):	
Purpose of borehole (check one): 🛛 Water Well 🔲 Geotech	nical/Geological Investigation
☐ Seismic Survey	Other (describe)
If drilling is not related to water well con	struction, skip the remainder of this block
Purpose of Well (check all applicable): ☐ Home ☐ Industrial ☐ P	
Other (describe):	
If a flowing well, method of flow regulation: Valve	Other (describe)
Static Water Level: 43' feet [□ above or ⊠ below (check one)	w] land surface Date measured: 07/12/2013
Method of Measurement (check one) $oximes$ Steel tape $oximes$ Electric tape	pe [] Air line [] Other: (describe)
Well depth: 126 Well grouted to a depth of: 10 feet	Type of grout (check one): ☐ Neat Cement ☑ Bentonite ☐ Mix
Casing length: 86 feet Casing diameter: 10	inches Type of casing: PVC
Screen length: 40 feet Screen diameter: 10	inches Type of screen: PVC
Screen slot size:050 inches Setting depth:	From <u>87 89</u> feet to <u>126</u> feet
Type of completion (check all applicable): $igtimes$ Gravel packed $igsqcup$ U	nderreamed  Open hole  Natural Development
Other (describe):	
Top of lap pipe or reduction in casing: Feet	DEC a 2 2014
If telescoped or more than on	e screen, describe on next page

Form: OLWR-SWR-1A (4/13)

County: Bolivar Permit #: GW-46725			For Office Use ( E217	Only:
The sketch below only required	<del>.</del>	Description of formations encountered m and boreholes, unless specifically exemp		ll wells
If well telescopes, show depths	on sketch.		_	- / t . 11
Ground level	,	Description of Formations Encountered	d From (depth) Ground level	To (depth)
	Company of the second of the s	Fine Sand	15	27
		Fine Sand & Gravel	28	56
		Medium Sand & Gravel	57	126
	ow location of each on sketch			
the well location     any permanent st	at and include the following: ructures on the property that ma lines, or other items that may ai	ly aid in locating the well d in locating the property and the well		
			RECEI	
				LUIT
Landowner Name:	Rocco Morris Jr.		BY: O	
requirements of the Miss if applicable, and state la <b>Patrick Chism</b>	issippi Department of Environme ws. 0695	onstructed, and completed in accordance ental Quality and the Mississippi Departme	with all applicable nt of Health regulati	SWR-1A (04/08) ons,
Print Name of Responsi	ble Licensee and License No.	Date Signa	ature of Licensee Form: OLWR-S	WR-1A (4/13)

County:	Bolivar	
Permit #:	GW-46725	
Driller:	Irrigation Eq	uipment
Date drilli	ng completed:	07/11/2013
		m block on Part 1

## STATE WELL REPORT


## Part 2

Pump Installer's Completion Report
Mississippi Department of Environmental Quality
Office of Land and Water Resources P.O. Box 2309 Jackson, MS 39225-2309 (601) 961-5210 (601) 360-0535 (fax)

For	Office Use Only:
Well #:	上217
Aquifer:	

Well Owner Information	partment at the above address within 30 days of well completion.  Well Location
Well Owner Information	Well Edulon
Owner Name: Rocco Morris Jr	Latitude: 33 55' 25.6 N Longitude: 90 40' 47.3 W
Mailing Address: 508 Westover Drive	Method of Lat/Long (check one):   Conventional Survey,
	☐ USGS quad, ☑ Hand-held GPS, ☐ Survey-grade GPS
Clarksdale Ms 38614	SE 1/4 SE 1/4, Sec 14 T 24 N R 5 W
City State Zip code	
Telephone No. ( ) -	5 Miles Southeast of Shelby
	(Distance) (Direction) (Nearest Town)
Pump Ty	ype (check one)
☑ Submersible ☐ Turbine ☐ Air Lift ☐ Centrifugal ☐ Flowing	Well □ Jet □ Piston □ Rotary □ Other (describe):
	Rated Pump Capacity: 900+/- Gallons Per Minute
s This Pump (check one): New Repaired Replaceme	
	ype (check one)
· Electric ☐ Diesel ☐ Gasoline ☐ Natural Gas ☐ Tractor PT	O □ Windmill □ Other (describe):
Horse Power Rating of Motor: 25 Setting Depth	
Torse Power Rating of Motor. 23 Setting Deptr	n. 10 reet Number of Stages. 1
	- 6 N Etd M-0
	a for Non Flowing Well
Date Well Tested:	Duration of Pump Test (minimum 4 hours): Hours
Date Well Tested:  Static Water Level (A): Feet Below Land Surface	Duration of Pump Test (minimum 4 hours): Hours  Pumping Water Level (B): Feet Below Land Surface
Date Well Tested:  Static Water Level (A):  Drawdown [(B) - (A)]:  Feet Below Land Surface  Feet Below Land Surface	Duration of Pump Test (minimum 4 hours): Hours  the Pumping Water Level (B): Feet Below Land Surface  Test Pumping Rate: Gallons Per Minute
Date Well Tested:  Static Water Level (A): Feet Below Land Surfac  Drawdown [(B) - (A)]: Feet Below Land Surfac  Method of measurement (check one):   Steel tape   Electric	Duration of Pump Test (minimum 4 hours): Hours  ce Pumping Water Level (B): Feet Below Land Surface  rface Test Pumping Rate: Gallons Per Minute  tape
Date Well Tested:  Static Water Level (A):  Drawdown [(B) - (A)]:  Method of measurement (check one):  Steel tape   Pump Test Date  Pump Test Date	Duration of Pump Test (minimum 4 hours): Hours  the Pumping Water Level (B): Feet Below Land Surface  Test Pumping Rate: Gallons Per Minute
Date Well Tested:  Static Water Level (A): Feet Below Land Surfact  Drawdown [(B) - (A)]: Feet Below Land Surfact  Method of measurement (check one):   Pump Test Date  Measured shut in head: Feet	Duration of Pump Test (minimum 4 hours): Hours  ce Pumping Water Level (B): Feet Below Land Surface  reface Test Pumping Rate: Gallons Per Minute  tape  Air line  Other (describe):
Date Well Tested:  Static Water Level (A): Feet Below Land Surfactor  Drawdown [(B) - (A)]: Feet Below Land Surfactor  Method of measurement (check one):   Pump Test Date  Measured shut in head: Feet	Duration of Pump Test (minimum 4 hours): Hours  ce Pumping Water Level (B): Feet Below Land Surface  rface Test Pumping Rate: Gallons Per Minute  tape
Date Well Tested:  Static Water Level (A): Feet Below Land Surfact  Drawdown [(B) - (A)]: Feet Below Land Surfact  Method of measurement (check one):   Pump Test Date  Measured shut in head: Feet  Well yielded GPM with a drawdown of	Duration of Pump Test (minimum 4 hours): Hours  ce Pumping Water Level (B): Feet Below Land Surface  rface Test Pumping Rate: Gallons Per Minute  tape [] Air line [] Other (describe):  pata for Flowing Well  feet after hours of pumping
Date Well Tested:  Static Water Level (A): Feet Below Land Surfact  Drawdown [(B) - (A)]: Feet Below Land Surfact  Method of measurement (check one):   Pump Test Date  Measured shut in head: Feet  Well yielded GPM with a drawdown of  Meter	Duration of Pump Test (minimum 4 hours): Hours  ce Pumping Water Level (B): Feet Below Land Surface  reface Test Pumping Rate: Gallons Per Minute  tape
Date Well Tested:  Static Water Level (A): Feet Below Land Surfactorawdown [(B) - (A)]: Feet Below Land Surfactorawdown [(B) - (A)]: Feet Below Land Surfactorate	Duration of Pump Test (minimum 4 hours): Hours  ce Pumping Water Level (B): Feet Below Land Surface  rface Test Pumping Rate: Gallons Per Minute  tape
Static Water Level (A): Feet Below Land Surfactor Feet Below L	Duration of Pump Test (minimum 4 hours): Hours  ce Pumping Water Level (B): Feet Below Land Surface  Inface Test Pumping Rate: Gallons Per Minute  Itape
Static Water Level (A): Feet Below Land Surfactor Feet Below Land Surfactor Water Level (A): Feet Below Land Surfactor Feet Below Land	Duration of Pump Test (minimum 4 hours): Hours  ce Pumping Water Level (B): Feet Below Land Surface  rface Test Pumping Rate: Gallons Per Minute  tape
Date Well Tested:  Static Water Level (A): Feet Below Land Surfactor [(B) - (A)]:	Duration of Pump Test (minimum 4 hours): Hours  ce Pumping Water Level (B): Feet Below Land Surface  Inface Test Pumping Rate: Gallons Per Minute  Itape
Static Water Level (A): Feet Below Land Surface  Drawdown [(B) - (A)]: Feet Below Land Surface  Method of measurement (check one): □ Steel tape □ Electric  Pump Test Definition  Measured shut in head: Feet  Meter Manufacturer: McCrometer  Meter Manufacturer: McCrometer  Meter Model Number/Name: 6"  Totalizer Register Unit and Multiplier Factor (AF x .001, gal x 10 installation Date: 07/12/2013 Meter installed by: □  S This Meter (check one): ☑ New □ Repaired □ Replaceme	Duration of Pump Test (minimum 4 hours): Hours  Duration of Pump Test (minimum 4 hours): Feet Below Land Surface  Pumping Water Level (B): Gallons Per Minute  Itape
Static Water Level (A): Feet Below Land Surface  Drawdown [(B) - (A)]: Feet Below Land Surface  Method of measurement (check one): □ Steel tape □ Electric  Pump Test Definition  Measured shut in head: Feet  Meter Meter Manufacturer: McCrometer  Meter Model Number/Name: 6"  Totalizer Register Unit and Multiplier Factor (AF x .001, gal x 10 installation Date: 07/12/2013	Duration of Pump Test (minimum 4 hours): Hours  Duration of Pump Test (minimum 4 hours): Hours  Duration of Pump Test (minimum 4 hours): Hours  Duration of Pump Test (minimum 4 hours): Feet Below Land Surface  If a compared to the control of the control of the compared to the control of the compared to the control of
Date Well Tested:  Static Water Level (A): Feet Below Land Surface  Drawdown [(B) - (A)]: Feet Below Land Surface  Method of measurement (check one): □ Steel tape □ Electric  Pump Test Definition  Measured shut in head: Feet  Well yielded GPM with a drawdown of  Meter Manufacturer: McCrometer  Meter Model Number/Name:6  Totalizer Register Unit and Multiplier Factor (AF x .001, gal x 10 and the stallation Date:07/12/2013	Duration of Pump Test (minimum 4 hours): Hours  Duration of Pump Test (minimum 4 hours): Feet Below Land Surface  Pumping Water Level (B): Gallons Per Minute  Itape
Date Well Tested:  Static Water Level (A): Feet Below Land Surface  Drawdown [(B) - (A)]: Feet Below Land Surface  Method of measurement (check one): □ Steel tape □ Electric  Pump Test Description  Measured shut in head: Feet  Well yielded GPM with a drawdown of  Meter Manufacturer: McCrometer  Meter Model Number/Name:  Meter Model Number/Name: 6  Totalizer Register Unit and Multiplier Factor (AF x .001, gal x 10 installation Date:	Duration of Pump Test (minimum 4 hours): Hours  the Pumping Water Level (B): Feet Below Land Surface  If are Gallons Per Minute  If the Other (describe):  Interest after hours of pumping  Installation Meter Serial Number: 13-05284  Type of Meter: Impellar  1000, etc):  Irrigation Equipment  Interest and and surfacturer standards.  Interest proved meters is on the MDEQ website.
Static Water Level (A): Feet Below Land Surfact Drawdown [(B) - (A)]: Feet Below Land Surfact Drawdown [(B) - (A)]: Feet Below Land Surfact Drawdown [(B) - (A)]: Feet Below Land Surfact Drawdown of Pump Test Drawdown of	Duration of Pump Test (minimum 4 hours): Hours  the Pumping Water Level (B): Feet Below Land Surface  If a per a feet Pumping Rate: Gallons Per Minute  If a per a feet after hours of pumping  Installation Meter Serial Number: 13-05284  Type of Meter: Impellar  1000, etc): Irrigation Equipment  Installation E

DEC 0 3 2014

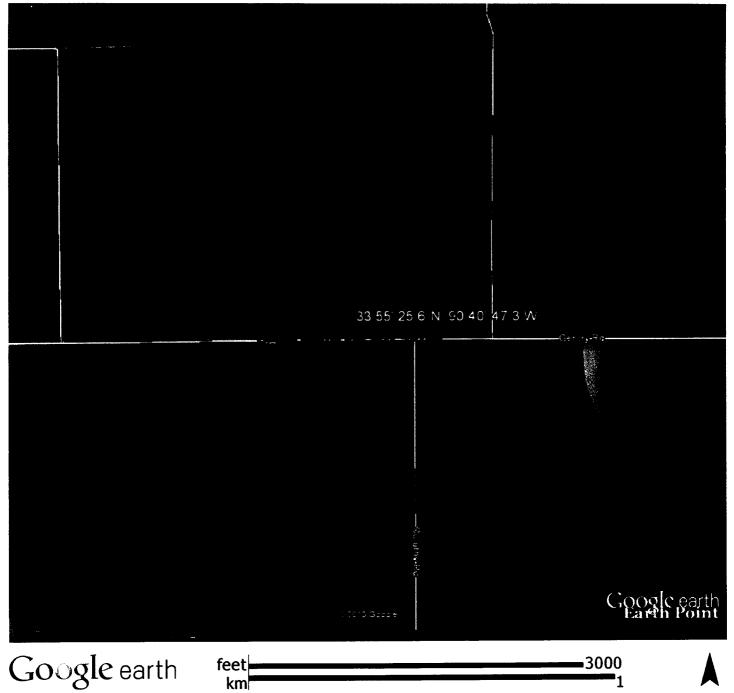

RECEIVED

DEC 9 3 2014

BY: OLWR