

State Well Report

Part I - Driller's Log

Mississippi Department of Environmental Quality
Office of Land and Water Resources
P.O. Box 2309
Jackson, MS 39225
(601)961-5210
(601)961-5228 (fax)

For Office Use Only:

Aquifer: E 218
Well #: _____
L. S. Elevation: _____
E-log #: _____

County: Bolivar
Permit #: GW-48923
Driller: TEDDY COOKS
Date drilling completed: 6/14/15

State Law requires that this report be prepared by the license holder responsible for the work and filed with the Department at the above address within 30 days of completion of drilling of the well or borehole.

Information on Well Owner <i>(Landowner if borehole is not for a water well)</i>	Well or Borehole Location
Owner Name: <u>American Farm Group</u>	Latitude: <u>33° 55' 38"</u> Longitude: <u>90° 40' 00"</u>
Mailing Address: _____	Method of Lat/Long (circle one): Conventional Survey, USGS quad, Hand-held GPS, Survey-grade GPS
<u>ste 405</u> <u>7700 North Kendall Drive</u>	SE 1/4 SW 1/4 Sec <u>13</u> Twn <u>24N</u> Rng <u>05W</u>
<u>Miami</u> <u>FL</u> <u>33156</u>	Distance <u>5</u> Miles Direction <u>East</u> of Nearest Town <u>Shelby</u>
City State Zip Code	
Telephone No. () _____	

Well / Borehole Data

Date drilling started: 6/14/15 Date drilling completed: 6/14/15 Hole depth: 110 Hole diameter: 28

Location of the source of any surface water used for drilling: Nearest Well
Method of dosing and volume of Chlorine used in drilling and development: _____

Logs run (circle all applicable): No log run Electric Gamma Ray Density Sonic Neutron Other: _____
Name of organization running log(s): DA

Purpose of borehole (check one): Water Well Geotechnical/Geological Investigation Ground Source Heat Pump
Seismic Survey Other (describe) _____

If drilling is not related to water well construction, skip the remainder of this block

Purpose of Well (check one): Home Industrial Public Supply Irrigation Fish Culture Other: _____

If a flowing well, method of flow regulation: Valve _____ Other (describe) _____

Static Water Level: 45 feet above or below (circle one) land surface Date measured: 6/14/15

Method of Measurement (circle one) steel tape electric tape air line other: _____

Well depth: 110 Well grouted to a depth of 10 feet Type of grout (circle one): Neat Cement Bentonite Mix

Casing length: 70 feet Casing diameter: 16 inches Type of casing: PVC

Screen length: 40 feet Screen diameter: 16 inches Type of screen: PVC

Screen slot size: 0.50 inches Setting depth: From 0 feet to 110 feet


Type of completion (circle all applicable): Gravel packed Underreamed Telescoped Open hole Natural Development
Other (describe): _____

Top of lap pipe or reduction in casing: _____ feet. *If telescoped or more than one screen, describe on next page*

The sketch below only required for water wells

Description of Formations encountered must be provided for all wells and boreholes, unless specifically exempted by regulation

If well telescopes, show depths on sketch

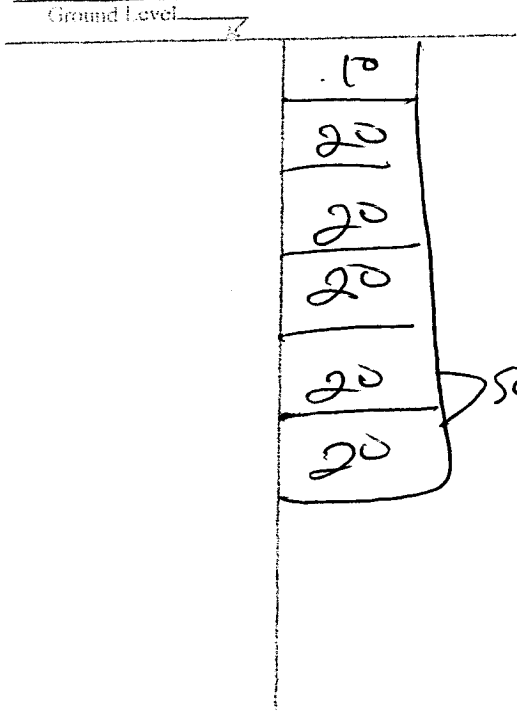

Description of Formations Encountered	From (depth) (Ground Level)	To (depth)
DIRT	0	10
COND	10	20
Good	20	40
See below	40	60
Gravel	60	80
Gravel	80	100
	100	110

If more than one screen, show location of each on sketch

Sketch the property layout and include the following: 1) the well location; 2) any permanent structures on the property that may aid in locating the well; 3) any roads, power lines, or other items that may aid in locating the property and the well; 4) a north arrow.

Landowner Name: American Farm Group

Form: OI.WR-SWR-1A (04/08)

I certify that the well/borehole was drilled, constructed, and completed in accordance with all applicable requirements of the Mississippi Department of Environmental Quality and the Mississippi Department of Health regulations, if applicable, and state laws.

TEDDY Coats #5318
Print Name of Responsible Licensee and License No.

6/14/15
Date


TEDDY Coats
Signature of Licensee

AUG 9 4 2016

MS DEPARTMENT OF ENVIRONMENTAL QUALITY



Copyright (C) 2010 MW, Topo, 2006-2015 TerraStar

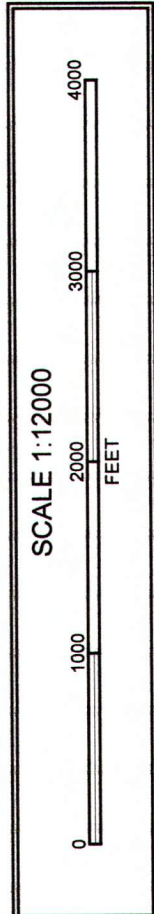

RECEIVED
 AUG 04 2015
 BY: OLWR

STATE WELL REPORT

Part 2

Pump Installer's Completion Report
 Mississippi Department of Environmental Quality
 Office of Land and Water Resources
 P.O. Box 2309
 Jackson, MS 39225-2309
 (601)961-5210
 (601) 360-0535 (fax)

For Office Use Only:

Well #: E.718

Aquifer: _____

County: BOLEVAR
 Permit #: GW-48923
 Driller: FEDDY COATS
 Date completed: 6-14-15
 Copy information from block on Part 1

This part of the report must be completed by a licensed water well contractor or a licensed pump installer. A copy of Part 1 of the report must be attached and both parts filed with the Department at the above address within 30 days of well completion.

Well Owner Information	Well Location
Owner Name: <u>AMERICAN FARM GROUP</u>	Latitude: <u>33° 55' 38"</u> Longitude: <u>90° 40' 00"</u>
Mailing Address: <u>7700 N. KENDALL DR</u>	Method of Lat/Long (check one): Conventional Survey _____, USGS quad _____, Hand-held GPS _____, Survey-grade GPS _____
<u>SWITE 405</u>	SE ¼ SW ¼, Sec <u>13</u> T <u>24N</u> R <u>05W</u>
<u>MIAMI</u> <u>FL</u> <u>33156</u>	<u>5 1/2</u> Miles <u>E</u> of <u>SHELBY</u>
City State Zip Code	(Distance) (Direction) (Nearest Town)
Telephone No. <u>(305) 279-8484</u>	

Pump Type (circle one)

Submersible Turbine Air Lift Centrifugal Flowing Well Jet Piston Rotary Other (describe): _____

Date Pump Installed: 6-15-15 Rated Pump Capacity: 2200 Gallons Per Minute

Is This Pump (circle one): New Repaired Replacement

Power Type (circle one)

Electric Diesel Gasoline Natural Gas Tractor PTO Windmill Other (describe): _____

Horse Power Rating of Motor: 60 Setting Depth: 70 feet Number of Stages: 2

Pump Test Data for Non Flowing Well

Date Well Tested: _____ Duration of Pump Test (minimum 4 hours): _____ hours

Static Water Level (A): 45 Feet Below Land Surface Pumping Water Level (B): _____ Feet Below Land Surface

Drawdown [(B) - (A)]: _____ Feet Below Land Surface Test Pumping Rate: _____ Gallons Per Minute

Method of measurement (circle one): Steel tape Electric tape Air line Other (describe): _____

Pump Test Data for Flowing Well

Measured shut in head: _____ feet.

Well yielded _____ GPM with a drawdown of _____ feet after _____ hours of pumping

Meter Installation

Meter Manufacturer: Mc Crometer Meter Serial Number: 14-13344

Meter Model Number/Name: M0308 Type of Meter: GROUNDWATER


Totalizer Register Unit and Multiplier Factor (AF x .001, gal x 1000, etc): _____

Installation Date: 6-13-15 Meter installed by: CIRCLE S IRRIGATION

Is This Meter (circle one): New Repaired Replacement

Important: By submitting the above information you are certifying that this meter was installed to manufacturer standards. For agricultural wells, a list of approved meters is on the MDEQ website.

I HEREBY CERTIFY that the above statements are true to the best of my knowledge.

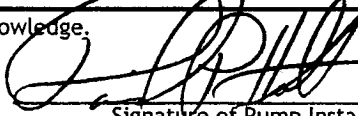DAVID P. HOLT 0-752P 7-3-15 

Print Name of Pump Installer and License No. (if applicable) Date Signature of Pump Installer

RECEIVED

BY OLWR

15-0255