

**BOLIVAR** MISSISSIPPI BOARD OF WATER COMMISSIONERS

**E-1006**

**5-30-63 WATER WELL DRILLERS LOG**


Date: 5/30, 1963, Driller: Fine County, Fine County, Bolivar 2  
(Name) Carlson

(1) Owner of Land <small>(Name)</small>	Description & Color of Materials Sand, Clay, Red Clay, Shell, etc.	Thick- ness Feet	Depth Feet
<u>Maywood Plant Inc</u>	<u>Backbat</u>	<u>16</u>	<u>16</u>
<small>(Address)</small>	<u>Fine Red Sand</u>	<u>13</u>	<u>29</u>
(2) Location: <u>1/4</u> , <u>1/4</u> , Sec. <u>T</u> <u>R</u>	<u>Course sand with gravel</u>	<u>13</u>	<u>42</u>
<u>6</u> miles <u>East</u> , of <u>Shelby</u>	<u>fine sand w/ gravel</u>	<u>6</u>	<u>48</u>
<small>(distance) (direction) (Nearest Town)</small>	<u>Course sand</u>	<u>13</u>	<u>61</u>
(3) Topography: <u>Flat</u>	<u>fine sand w/ gravel</u>	<u>20</u>	<u>81</u>
<small>(Hilly) (Flat) (Level)</small>	<u>Very fine sand</u>	<u>7</u>	<u>88</u>
(4) Purpose of Well: <u>Irrigation Rice</u>	<u>Course sand w/ gravel</u>	<u>20</u>	<u>108</u>
<small>(Domestic, Irrigation, Municipal, Industrial, Other)</small>			

Information upon completion of well:

- (1) Diameter 16 inches.
- (2) Total Depth 108 feet.
- (3) Water Level 22 feet below top of ground.
- (4) Cased to 38, Size 16"
- (5) Screen: Size 16x14, Length 20'
- (6) Were any formations sealed against pollution?  
 yes,  no.

If YES depth of formation \_\_\_\_\_  
 Why \_\_\_\_\_  
 Drillers Remarks \_\_\_\_\_

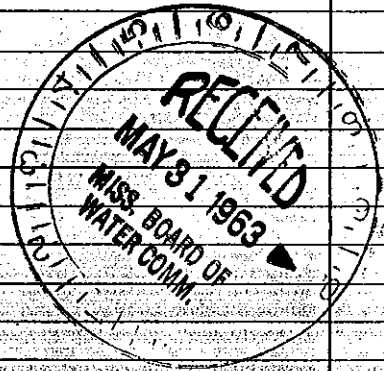

Well No.

(Use Back Side)

Mail this copy to Board of Water Commissioners 429 Miss. St. Jackson, Miss.