

**BOLIVAR** MISSISSIPPI BOARD OF WATER COMMISSIONERS

E-1007  
3-20-63

**WATER WELL DRILLERS LOG**

Date: 3/20, 1963, Driller: Finis County James Bolivar  
(Name)

(1) Owner of Land:	Description & Color of Materials Sand, Clay, Red Clay, Shell, etc.	Thick- ness Feet	Depth Feet
<u>Maryland Stratton</u> (Name)	<u>Clay</u>	<u>7</u>	<u>7</u>
<u>Shelby, Miss</u> (Address)	<u>Red clay, Sand</u>	<u>5</u>	<u>12</u>
(2) Location: <u>1/4</u> , <u>1/4</u> , Sec. <u>T</u> <u>R</u>	<u>Fine Sand</u>	<u>5</u>	<u>17</u>
<u>6</u> miles <u>East</u> of <u>Shelby</u>	<u>C. Sand</u>	<u>30</u>	<u>47</u>
(distance) (direction) (Nearest Town)	<u>C. Sand - gravel</u>	<u>18</u>	<u>57</u>
(3) Topography: <u>Level</u>	<u>Fine Sand</u>	<u>8</u>	<u>65</u>
(Hilly) (Flat) (Level)	<u>C. Sand</u>	<u>43</u>	<u>108</u>
(4) Purpose of Well: <u>irrigation</u>	<u>Hard clay bottom</u>		
(Domestic Irrigation Municipal, Industrial, Other)			


Information upon completion of well:

- (1) Diameter 16 inches.
- (2) Total Depth 108 feet.
- (3) Water Level 26 feet below top of ground.
- (4) Cased to 6.0, Size 4 1/2" 16"
- (5) Screen: Size 12, Length 48
- (6) Were any formations sealed against pollution?  
no.

If YES depth of formation \_\_\_\_\_

Why \_\_\_\_\_

Drillers Remarks: \_\_\_\_\_

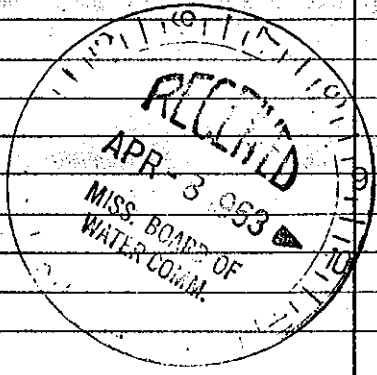

Well No. \_\_\_\_\_

(Use Back Side)

Mail this copy to Board of Water Commissioners 429 Miss. St. Jackson, Miss.