

Bolivar
758
11-4-68

MISSISSIPPI
 BOARD OF WATER COMMISSIONERS
 416 North State Street
 Jackson, Mississippi 39201

CODED

WATER WELL DRILLERS LOG

11/4/68 19 *October 11 & Supply* *Bolivar*
 date well completed firm name county well located


LANDOWNER: *Sumner Dairy*
W. Smith & C. Smith
R. F. D. Cleveland
 (mailing address)

description of formations encountered	from	to
<i>Top Clay</i>	<i>0</i>	<i>24</i>
<i>Clay & Fine Sand</i>	<i>24</i>	<i>64</i>
<i>Fine Sand</i>	<i>64</i>	<i>75</i>
<i>Sand & Gravel</i>	<i>75</i>	<i>116</i>
<i>Blue Clay ?</i>		

WELL LOCATION:
 sec. *12* T. *32* N R. *7* W
3 1/2 miles *210 - road* of *Pass*
 (distance) (direction) (nearest town)

WELL PURPOSE: *Irrigation*
 (home, irrigation, municipal, industrial)

- WELL COMPLETION DATA:
- (1) diameter (inches) *16"*
 - (2) total depth (feet) *116*
 - (3) static water level (feet) *23* below above top of ground.
 - (4) casing *Steel* (material), (depth)
 (size) if telescope see back.
 - (5) screen *40* (length), (depth to top)
16 (size), *Steel* (material)
 - (6) pump *25* (HP), *1500* (yield gpm)
Elec (type power)
 - (7) electric log (yes or no)
 (organization running log)
 - (8) how well bottom plugged *Cracked*

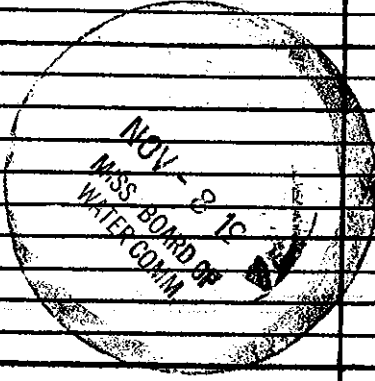

CODED

DRILLERS REMARKS: