

Bolivar
F-70
 1-60

MISSISSIPPI BOARD OF WATER COMMISSIONERS

WATER WELL DRILLERS LOG

1/21/66 *C803*
CODED

Date: Jan. 27, 1960, Driller: Layne-Central Company *Bolivar*

(Name)

Holleman

(1) Owner of Land: Sillers, Pearson &

(Name)

Rosedale, Mississippi

(Address)

(2) Location: 1/4, 1/4, Sec. 2 T23R7

3 miles north of Malvina

(distance) (direction) (Nearest Town)

(3) Topography: flat

(Hilly) (Flat) (Level)

(4) Purpose of Well: irrigation

(Domestic Irrigation
 Municipal, Industrial, Other)

Description & Color of Materials Sand, Clay, Red Clay, Shell, etc.	Thick- ness Feet	Depth Feet
Clay	18	18
Fine silky sand	17	35
Medium sand	5	40
Coarse sand & pea gravel	60	100
Big rocks	10	110

Information upon completion of well:

(1) Diameter 16 inches.

(2) Total Depth 110 feet.

(3) Water Level 18' 2" feet below top of ground.

(4) Cased to 60', Size 16"

(5) Screen: Size 16", Length 50'

(6) Were any formations sealed against pollution?

no yes, no no.

If YES depth of formation


Why

Drillers Remarks:

2800 GPM.

Electric power.

CODED

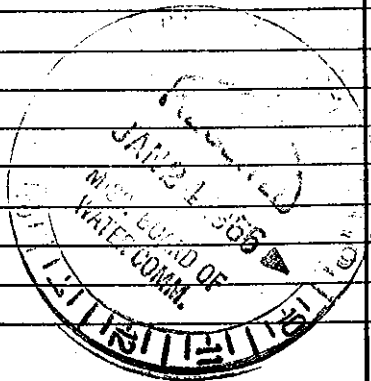

(Use Back Side)

Well No.

Mail this copy to Board of Water Commissioners 429 Miss. St. Jackson, Miss.