

BOLIVAR

F-72

4-17-57

MISSISSIPPI BOARD OF WATER COMMISSIONERS

WATER WELL DRILLERS LOG

*9/20/65 well #2
for c 394*

Date: April 17, 1957, Driller: Layne-Central Company County Bolivar

(Name)

CODED

(1) Owner of Land: Estate of J.E. Dattel & Bertie Dattel
(Name)

Rosedale, Mississippi
(Address)

(2) Location: 1/4, 1/4, Sec. 13 T23R17

5 miles east of Rosedale
(distance) (direction) (Nearest Town)

(3) Topography: flat
(Hilly) (Flat) (Level)

(4) Purpose of Well: irrigation
(Domestic Irrigation
Municipal, Industrial, Other)

Description & Color of Material	Depth Feet
Clay	14
Fine sand	6
Blue clay	15
Medium sand	17
Coarse sand	20
Coarse sand, pea gravel	20
Coarse sand, pea gravel & big rocks	20

Information upon completion of well:

- (1) Diameter 18x16 inches.
- (2) Total Depth 112 feet.
- (3) Water Level 22' - 3" feet below top of ground.
- (4) Cased to 60' Size 18"
2' of 18" x 16" swage
- (5) Screen: Size 16", Length 50'
- (6) Were any formations sealed against pollution?
no yes, no no.

If YES depth of formation _____


Why _____

Drillers Remarks: _____

3146 GPM.

Engine drive.

CODED

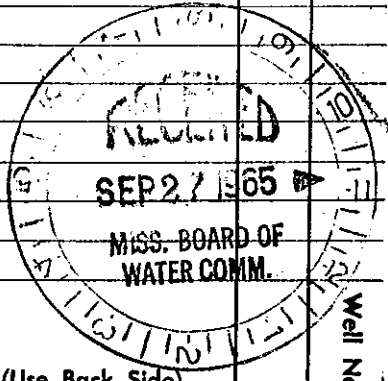

(Use Back Side)

Well No.

Mail this copy to Board of Water Commissioners 429 Miss. St. Jackson, Miss