

BOLIVAR

F-73

5-11-57

MISSISSIPPI BOARD OF WATER COMMISSIONERS

WATER WELL DRILLERS LOG

Well #71
9/22/65 C 394

Date: May 11, 1957, Driller: Layne-Central Company Bolivar

(Name)

CODED

Estate of	Description & Color of Material	Depth
(1) Owner of Land: <u>J.E. Dattel & Bertie Dattel</u>	Sand, Clay, Red Clay, Shell	Feet
(Name) <u>Dattel</u>	Clay	59
Address: <u>Rosedale, Mississippi</u>	Fine sand	4
(Address)	Coarse sand	9
(2) Location: <u>1/4, 1/4, Sec. 5, T23 R6</u>	Fine sand	6
<u>3</u> miles <u>east</u> of <u>Rosedale</u>	Coarse sand	28
(distance) (direction) (Nearest Town)	Medium sand	1
(3) Topography: <u>flat</u>	Coarse sand, pea gravel	23
(Hilly) (Flat) (Level)	Fine red sand in big	
(4) Purpose of Well: <u>irrigation</u>	gravel	2
(Domestic Irrigation Municipal, Industrial, Other)		

Information upon completion of well:

- (1) Diameter 18x12 inches.
- (2) Total Depth 130 feet.
- (3) Water Level 21'10" feet below top of ground.
- (4) Cased to 73' of 18" x 12" swage size 18"
- (5) Screen: Size 12", Length 50'
- (6) Were any formations sealed against pollution?
no yes, no no.

CODED


If YES depth of formation _____

Why _____

Drillers Remarks: _____

2435 GPM.

Engine drive.

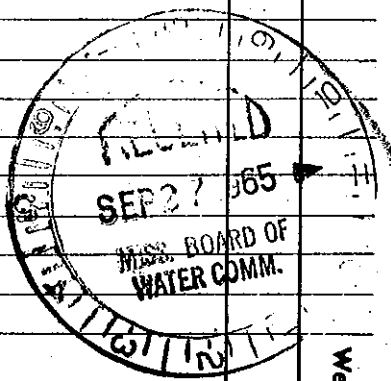

(Use Back Side)

Well No.

Mail this copy to Board of Water Commissioners 429 Miss. St. Jackson, Miss