

**BOLIVAR**

MISSISSIPPI BOARD OF WATER COMMISSIONER

**CODED**

**F-74**

**3-20-57 WATER WELL DRILLERS LOG**

*C 339*

Date: Mar. 20, 19 57, Driller: Layne-Central Company County Bolivar

(Name)

	Description & Color of Materials Sand, Clay, Red Clay, Shell, etc.	Thick- ness Feet	Depth Feet
(1) Owner of Land: <u>Cal Busby</u> (Name)	<u>Clay</u>	<u>14</u>	<u>14</u>
<u>Cleveland, Mississippi</u> (Address)	<u>Fine sand</u>	<u>34</u>	<u>48</u>
<u>Code 6</u> (2) Location: <u>1/4</u> , <u>1/4</u> , Sec. <u>33</u> , T. <u>23</u> N. R. <u>7</u> W.	<u>Coarse sand</u>	<u>46</u>	<u>94</u>
<u>4</u> miles <u>west</u> of <u>Pace</u> (distance) (direction) (Nearest Town)	<u>Coarse sand, pea gravel</u>	<u>18</u>	<u>112</u>
(3) Topography: <u>flat</u> (Hilly) (Flat) (Level)			
(4) Purpose of Well: <u>irrigation</u> (Domestic Irrigation Municipal, Industrial, Other)			

Information upon completion of well:

- (1) Diameter 16x12 inches.
- (2) Total Depth 112 feet.
- (3) Water Level 18'-5" feet below top of ground.
- (4) Cased to 71', Size 16",  
1' swage
- (5) Screen: Size 12", Length 40'.
- (6) Were any formations sealed against pollution?  
no yes, no no.

If YES depth of formation \_\_\_\_\_


Why \_\_\_\_\_

Drillers Remarks: \_\_\_\_\_

1700 GPM

electric power

**CODED**

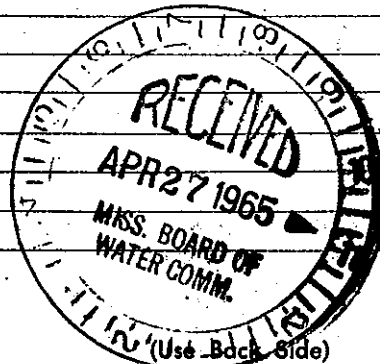

Well No. \_\_\_\_\_

Mail this copy to Board of Water Commissioners 429 Miss. St. Jackson, Miss.