

BOLIVAR
F-75

MISSISSIPPI BOARD OF WATER COMMISSIONERS

9/24/65

2427

5-21-57 WATER WELL DRILLERS LOG

Date: May 21, 19 57, Driller: Layne-Central Company County Bolivar

(Name)

CODED

(1) Owner of Land: Ben A. Bogy
(Name)
Malvina, Mississippi
(Address)

(2) Location: 1/4, 1/4, Sec. 23 T23R7,
2 miles north, of Symond
(distance) (direction) (Nearest Town)

(3) Topography: flat
(Hilly) (Flat) (Level)

(4) Purpose of Well: irrigation
(Domestic Irrigation
Municipal, Industrial, Other)

Description & Color Sand, Clay, Red Clay, Shell, etc.	Thick- ness Feet	Depth Feet
Clay	24	24
Fine sand	29	53
Medium sand	5	58
Coarse sand	11	69
Coarse sand, pea gravel	48	117
Fine black sand		117

Information upon completion of well:

(1) Diameter. 18x12 inches.

(2) Total Depth. 117 feet.

(3) Water Level. 20' 5" feet below top of ground.

(4) Cased to 62', Size 18"
5' of 18" x 12" swage

(5) Screen: Size 12", Length 50'

(6) Were any formations sealed against pollution?
no yes, no no.

CODED


If YES depth of formation _____

Why _____

Drillers Remarks: _____

2409 GPM.

Electric power.

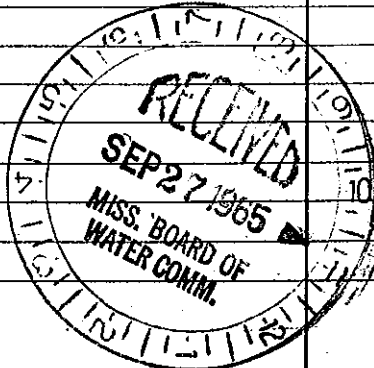

(Use Back Side)

Well No.

Mail this copy to Board of Water Commissioners 429 Miss. St. Jackson, Miss.