

BOLIVAR

MISSISSIPPI BOARD OF WATER COMMISSIONERS

F-77

3-20-58

WATER WELL DRILLERS LOG

10/8/65
me 525

Date: March 20, 1958, Driller: Layne-Central Company County Bolivar

(Name)

CODED

(1) Owner of Land: Ben A. Bogy
(Name)
Malvina, Mississippi
(Address)

(2) Location: Code 6 1/4, 10 1/4, Sec. 23 T23R7
_____ miles _____ of Malvina
(distance) (direction) (Nearest Town)

(3) Topography: flat
(Hilly) (Flat) (Level)

(4) Purpose of Well: domestic
(Domestic Irrigation
Municipal, Industrial, Other)

Description & Color Sand, Clay, Red Clay, Shell, etc.	Thick- ness Feet	Depth Feet
Top soil	1	1
Clay	18	19
Muddy sand	23	42
Sand	26	68
Sand & small gravel	96	164
Rock	2	166
Fine sand strks. shale	63	229
Shale strks. sand	19	248
Shale	44	292
Sand strks. shale	11	303
Shale	37	340
Shale strks. sand	22	362
Sand	3	365
Rock	1	366
Sand	2	368
Shale	9	377
HP sand strks. shale & lignite	20	397
HP sand strks. shale & lignite	23	420
HP sand strks. shale & lignite	23	443
HP sand strks. shale & lignite	19	462
Shale	4	466

CODED

Information upon completion of well:

(1) Diameter 3 inches.

(2) Total Depth 467' 5" feet.

(3) Water Level 19 feet below top of ground.

(4) Cased to 421' 9", Size 3"

(5) Screen: Size 3", Length 21' 2"
24' 6" of 3" blank

(6) Were any formations sealed against pollution?
yes yes, _____ no.


If YES depth of formation packer above screen and 2' slugs at bottom.

Why _____

Drillers Remarks: _____

15 GPM.

Electric power.

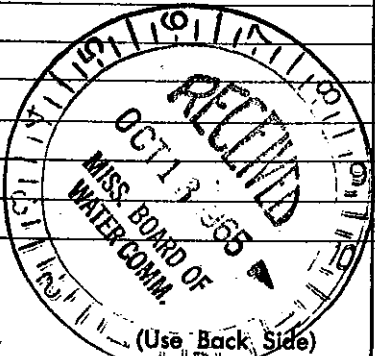

Well No.