

**BOLIVAR MISSISSIPPI BOARD OF WATER COMMISSIONERS**

**F-79**  
**4-27-61**

**WATER WELL DRILLERS LOG**

**F 301**

Date: April 27, 19 61, Driller: Layne-Central Company County Bolivar

(Name)

(1) Owner of Land: R. C. Malone  
(Name)  
Cleveland, Mississippi  
(Address)  
Beulah, Mississippi

(2) Location: 1/4, 1/4, Sec. T. R.  
15 23N 8W  
2 miles north, of Beulah  
(distance) (direction) (Nearest Town)

(3) Topography: flat  
(Hilly) (Flat) (Level)

(4) Purpose of Well: domestic  
(Domestic Irrigation  
Municipal, Industrial, Other)

Description & Color of Materials Sand, Clay, Red Clay, Shell, etc.	Thick- ness Feet	Depth Feet
Clay	15	15
Sandy clay		25
Coarse brown sand & pea gravel	13	38
Clay	2	40
Fine sand	30	70
Coarse sand	25	95
Coarse sand & pea gravel	65	160
Coarse sand	77	237
White & blue clay	18	255
Clay, strks. of sandy clay	20	275
Clay, sand streaks	24	298
Sand	14	312
White clay	23	335
Sandy shale & clay strks.	50	385
Fine sand	21	406
Sand, strks. of shale	68	474
Clay	16	490
Sand & clay	10	500
Clay & shale	27	527
Sand	116	643
Clay	6	649
Sandy shale & clay strks.	32	681
Sand	33	714
Clay & sandy shale	21	735
Fine sand	9	744
Sand	66	810

Information upon completion of well:

(1) Diameter 4x3 inches.

(2) Total Depth 810' feet.

(3) Water Level 22' feet below top of ground.  
669' 3"

(4) Cased to 107', Size 4"  
7 7/8"


(5) Screen: Size 8003", Length 30'

(6) Were any formations sealed against pollution?  
yes, X no.

If YES depth of formation above the screen

Why to eliminate all other formations.

Drillers Remarks:

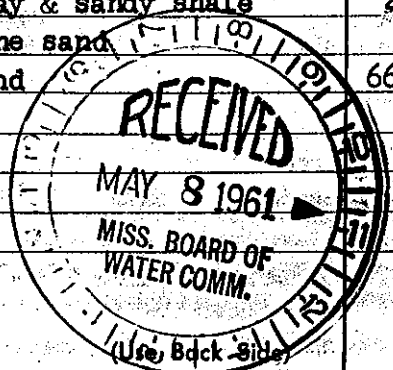

Well No.

Mail this copy to Board of Water Commissioners 429 Miss. St. Jackson, Miss.