

BOLIVAR MISSISSIPPI BOARD OF WATER COMMISSIONERS

F-81
4-3-65

WATER WELL DRILLERS LOG

CODED


Date: 4/3, 1965, Driller: Delta Well Supply County Bolivar
(Name)

(1) Owner of Land: <u>Wm. C. Allen Jr.</u> (Name)	Description & Color of Materials Sand, Clay, Red Clay, Shell, etc.	Thick- ness Feet	Depth Feet
<u>Rosedale</u> (Address)	<u>Clay</u>	<u>24</u>	
(2) Location: <u>1/4</u> , <u>1/4</u> , Sec. <u>26</u> T <u>23</u> R <u>7</u>	<u>Sand Blue Clay</u>	<u>30</u>	<u>54</u>
<u>2</u> miles <u>West</u> , of <u>Puca</u> (distance) (direction) (Nearest Town)	<u>Sand loose</u>	<u>33</u>	<u>89</u>
(3) Topography: _____ (Hilly) (Flat) (Level)	<u>sand + gravel</u>	<u>33</u>	<u>122</u>
(4) Purpose of Well: <u>Irrigation</u> (Domestic, Irrigation, Municipal, Industrial, Other)			

Information upon completion of well:

- (1) Diameter 16 inches.
- (2) Total Depth 122 feet.
- (3) Water Level 21 feet below top of ground.
- (4) Cased to _____, Size _____
- (5) Screen: Size 16", Length 40 ft.
- (6) Were any formations sealed against pollution?
_____ yes, _____ no.

3000 S.P.M.

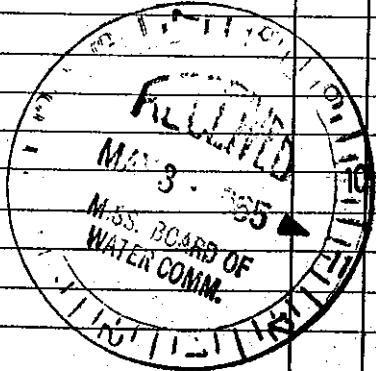

CODED

(Use Back Side)

Well No.

Mail this copy to Board of Water Commissioners 429 Miss. St. Jackson, Miss.