

**F90**

**3-24-63**

**WATER WELL DRILLERS LOG**

Date: 3/24, 1963, Driller: Delta Well Supply County Bolivar  
(Name)

(1) Owner of Land: <u>W.P. Skilton</u> (Name)	Description & Color of Materials Sand, Clay, Red Clay, Shell, etc.	Thick- ness Feet	Depth Feet
<u>RFD - Rosedale</u> (Address)	<u>Sand Buck shot</u>	<u>19</u>	
(2) Location: <u>1/4, 1/4, Sec. 1 T23R2W</u>	<u>Fine sand &amp; clay</u>	<u>20</u>	<u>39</u>
<u>5</u> miles <u>N to W</u> of <u>Paice</u> (distance) (direction) (Nearest Town)	<u>1/4 Sand</u>	<u>76</u>	<u>55</u>
(3) Topography: <input checked="" type="checkbox"/> (Hilly) <input type="checkbox"/> (Flat) <input type="checkbox"/> (Level)	<u>C. to fine sand,</u>		
(4) Purpose of Well: <u>Irrigation</u> (Domestic Irrigation, Municipal, Industrial, Other)	<u>Trace of gravel</u>	<u>54</u>	<u>109</u>
	<u>Rock</u>	<u>8</u>	<u>109.8</u>
	<u>Sand &amp; gravel</u>	<u>9</u>	<u>118.8</u>

**CODED**


**Information upon completion of well:**

- (1) Diameter 16 inches.
- (2) Total Depth 118' 8" feet.
- (3) Water Level 19 feet below top of ground.
- (4) Cased to \_\_\_\_\_, Size \_\_\_\_\_.
- (5) Screen: Size 16, Length 40 ft.
- (6) Were any formations sealed against pollution?  
\_\_\_\_\_ yes,  no.

If YES depth of formation \_\_\_\_\_

Why \_\_\_\_\_

Drillers Remarks: \_\_\_\_\_

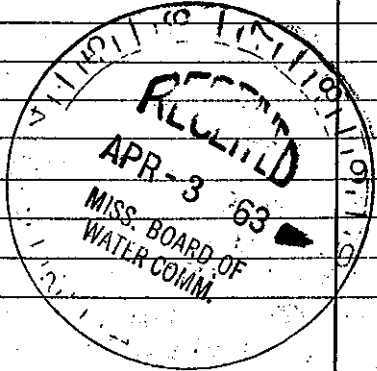

(Use Back Side)

Well No