

F 91 <sup>105</sup>  
3-8-63

**WATER WELL DRILLERS LOG**

Date: 3/8, 1963, Driller: Delta Well Supply county Bolivar  
(Name)

(1) Owner of Land: <u>W.P. Sketton</u> (Name)	Description & Color of Materials Sand, Clay, Red Clay, Shell, etc.	Thick- ness Feet	Depth Feet
<u>R.F.D. - Rosedale</u> (Address)	<u>sandy loam</u>	<u>18</u>	
(2) Location: <u>1/4, 1/4, Sec. 16 T23R7W</u>	<u>Fine Sand</u>	<u>42</u>	<u>60</u>
<u>3</u> miles <u>NW</u> of <u>Pace</u> (distance) (direction) (Nearest Town)	<u>Sand &amp; gravel</u>	<u>59</u>	<u>119</u>
(3) Topography: <input checked="" type="checkbox"/> (Hilly) <input type="checkbox"/> (Flat) <input type="checkbox"/> (Level)	<b>CODED</b>		
(4) Purpose of Well: _____ (Domestic Irrigation Municipal, Industrial, Other)			


Information upon completion of well:

- (1) Diameter 12 inches.
- (2) Total Depth 119 feet.
- (3) Water Level 21 feet below top of ground.
- (4) Cased to \_\_\_\_\_, Size \_\_\_\_\_
- (5) Screen: Size 12, Length 40 ft
- (6) Were any formations sealed against pollution?  
\_\_\_\_\_ yes,  no.

If YES depth of formation \_\_\_\_\_

Why \_\_\_\_\_

Drillers Remarks: \_\_\_\_\_

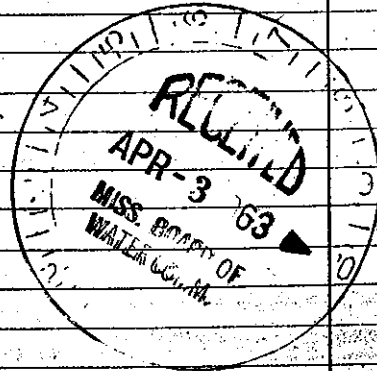

Well No \_\_\_\_\_

(Use Back Side)