

BOLIVAR

F 93

2-5-64

MISSISSIPPI BOARD OF WATER COMMISSIONERS

WATER WELL DRILLERS LOG

CODED  
2/11/64  
C1716

Date: Feb. 5, 1964, Driller: Layne-Central Company, County Bolivar

(Name)

(1) Owner of land: C. B. Patterson

(Name)

Rosedale, Mississippi

(Address)

T23N

(2) Location: 1/4, 1/4, Sec. 15 T. R7W

miles of Malvina  
(distance) (direction) (Nearest Town)

(3) Topography: flat

(Hilly) (Flat) (Level)

(4) Purpose of Well: irrigation

(Domestic Irrigation  
Municipal, Industrial, Other)

Information upon completion of well:

(1) Diameter 16" inches.

(2) Total Depth 112 feet.

(3) Water Level 22' - 2" feet below top of ground.

(4) Cased to 62', Size 16"

(5) Screen: Size 16", Length 50'

(6) Were any formations sealed against pollution?

yes, no no.

If YES depth of formation

Why

Drillers Remarks:

Description & Color of Materials  
Sand, Clay, Red Clay, Shell, etc.

Thick-  
ness  
Feet

Depth  
Feet


Clay 28 28

Coarse sand 12 40

Coarse sand, pea gravel 50 90

Coarse sand, gravel 22 112

CODED

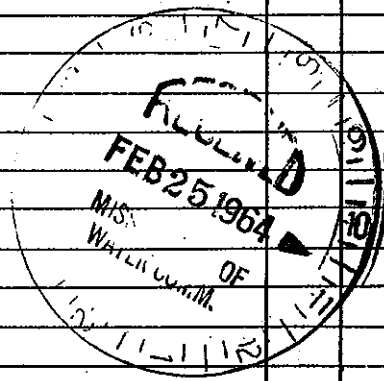

Well No.

(Use Back Side)

Mail this copy to Board of Water Commissioners 429 Miss. St. Jackson, Miss.