

Bolivar
F 102
8-1-74

MISSISSIPPI
 BOARD OF WATER COMMISSIONERS
 416 North State Street
 Jackson, Mississippi 39201


CODED

WATER WELL DRILLERS LOG

8/1 1974 Delta Well Supply Co. Bolivar
 date well completed firm name county well located

LANDOWNER:	description of formations encountered	from	to
(mailing address)			
<u>Robbins & Long</u>	<u>top soil</u>	<u>0</u>	<u>36</u>
<u>Rosedale Miss</u>	<u>sand</u>	<u>36</u>	<u>80</u>
	<u>gravel</u>	<u>80</u>	<u>130</u>
	<u>clay</u>	<u>130</u>	<u>210</u>
	<u>sand</u>	<u>210</u>	<u>245</u>
	<u>clay</u>	<u>245</u>	<u>357</u>
	<u>sand</u>	<u>357</u>	<u>472</u>
	<u>clay</u>	<u>472</u>	<u>525</u>
	<u>set @ 472</u>		
WELL LOCATION:			
sec. <u>10</u> T. <u>23</u> N R. <u>8</u> W			
<u>1/2</u> miles <u>East</u> of <u>Rosedale</u>			
(distance) (direction) (nearest town)			
WELL PURPOSE: <u>Home</u>			
(home, irrigation, municipal, industrial)			
WELL COMPLETION DATA:			
(1) diameter (inches) <u>4 1/2</u>			
(2) total depth (feet) <u>472</u>			
(3) static water level (feet) <u>21</u> below above top of ground.			
(4) casing <u>Galv. pipe</u> (material) (depth)			
(size) If telescope see back.			
(5) screen <u>30</u> (length) (depth to top)			
<u>2</u> (size) <u>Stainless Steel</u> (material)			
(6) pump <u>2</u> (HP) <u>30</u> (yield gpm)			
<u>elec</u> (type power)			
(7) electric log <u>No</u> (yes or no)			
(organization running log)			
(8) how well bottom plugged <u>B.P. Valve</u>			
DRILLERS REMARKS:			

CODED

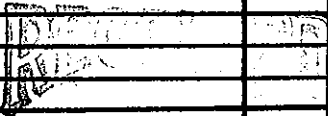

MISS. Bd. of Water Comm.