

CODED

CODED

2/15/67
C 2336R

Bolivar
F 108
1-67

MISSISSIPPI
BOARD OF WATER COMMISSIONERS
416 North State Street
Jackson, Mississippi 39201

WATER WELL DRILLERS LOG

January 26, 1967 Layne-Central Company Bolivar
date well completed firm name county well located

LANDOWNERS Long & Robbins

(L. & R. Platation)

Rosedale, Mississippi
(mailing address)

WELL LOCATION:

sec. 24 T. 23 N R. 8 E
X W
1 1/2 miles southeast Rosedale
(distance) (direction) (nearest town)

WELL PURPOSE: Irrigation
(home, irrigation, municipal, industrial)

WELL COMPLETION DATA:


- (1) diameter (inches) 16
- (2) total depth (feet) 141
- (3) static water level (feet) 23' 1" below top of ground.
- (4) casing steel 91'
(material) (depth)
16" if telescope see back.
(size)
- (5) screen 50' 91'
(length) (depth to top)
16" Armco iron
(size) (material)
- (6) pump (HP) (yield gpm)
electric
(type power)
- (7) electric log no
(yes or no)
(organization running log)
- (8) how well bottom plugged plate

description of formations encountered

from to

Top soil	0	4
Sandy clay	4	17
Blue clay	17	74
Clay balls & gravel	74	76
Fine sand, clay balls	76	83
Clay balls, gravel & old wood	83	88
Coarse sand & gravel	88	128
Sand	128	132
Coarse sand, gravel	132	141

CODED

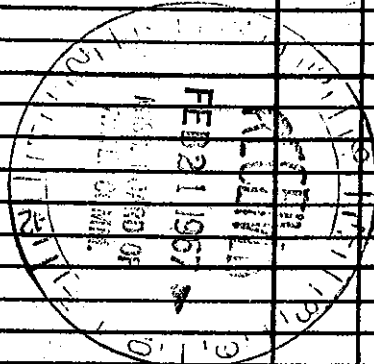

DRILLERS REMARKS: