

BOLIVAR

MISSISSIPPI BOARD OF WATER COMMISSIONERS

8-9-65

CODED

WATER WELL DRILLERS LOG

CODED

11/4/65
Shell #3
C1946

Date: Aug. 28, 1965, Driller: Layne-Central Company County Bolivar

(Name)

Bolivar County Conservation League
 (1) Owner of Land: Conservation League
Conservation Lake (Name)
Cleveland, Mississippi
 (Address)

(2) Location: 1/4, 1/4, Sec. 6 T23N R8W
 (distance) (direction) (Nearest Town)

(3) Topography: flat
 (Hilly) (Flat) (Level)

(4) Purpose of Well: irrigation
 (Domestic Irrigation Municipal, Industrial, Other)

Description & Color of Materials Sand, Clay, Red Clay, Shell, etc.	Thick- ness Feet	Depth Feet
Clay	8	8
Clay balls	17	25
Sand	10	35
Sand, pea gravel	40	75
Gravel, pea gravel, sand	43	118
Big boulders, gravel	7	125
Clay	50	175
Sandy shale	50	225
Clay pink	30	255
Sandy shale	100	355
Sand strks.	107	462

Information upon completion of well:


- (1) Diameter 12x8 inches.
- (2) Total Depth 470' 2" feet.
- (3) Water Level 4' 7" feet below top of ground.
219' 6" 8"
- (4) Cased to 137' 6", Size 12"
1' 9" of 12" x 8" swage
- (5) Screen: Size 8", Length 101' 3"
- (6) Were any formations sealed against pollution?
no yes, no no.

CODED

If YES depth of formation _____

Why _____

Drillers Remarks: _____

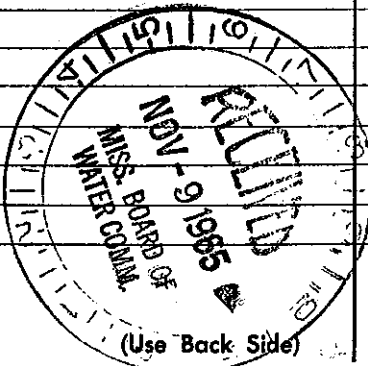

Well No.

Mail this copy to Board of Water Commissioners 429 Miss. St. Jackson, Miss.