

BOLIVAR MISSISSIPPI BOARD OF WATER COMMISSIONERS

KF 112
6-24-64

WATER WELL DRILLERS LOG

9/24/64 CODED
jm C1777R

Date: June 24, 1964, Driller: Layne-Central Company County Bolivar

(Name)

Conservation Lake, Bolivar
 (1) Owner of Land: County Conservation
 (Name) League
Cleveland, Mississippi
 (Address)
 (2) Location: 1/4, 1/4, Sec. 6 T23N R7W
15 miles west of Cleveland
 (distance) (direction) (Nearest Town)
 (3) Topography: flat
 (Hilly) (Flat) (Level)
 (4) Purpose of Well: domestic
 (Domestic Irrigation Municipal, Industrial, Other)


Description & Color of Materials Sand, Clay, Red Clay, Shell, etc.	Thick- ness Feet	Depth Feet
Clay	6	6
Sand	39	45
Coarse sand	28	73
Coarse sand & pea gravel	35	108
Coarse sand & gravel	9	117
Sand	22	139
Cemented gravel & sand	3	142
Clay	60	202
Shale	43	245
Clay	45	290
Sand (soft)	48	338
Sand	36	374
Shale & lignite	2	376
Sand	14	390
Shale	12	402
Sand	67	469

Information upon completion of well:

(1) Diameter 8 1/4 inches.
 (2) Total Depth 393' - 11" feet.
 (3) Water Level 8' - 8" feet below top of ground.
235' - 10" 4"
 (4) Cased to 114' - 2", Size 8"
 (5) Screen: Size 4", Length 41' - 2"
 (6) Were any formations sealed against pollution?
yes yes, no no.

If YES depth of formation Packer above the screen and B.P.V. at the bottom.
 Why _____
 Drillers Remarks: _____

CODED

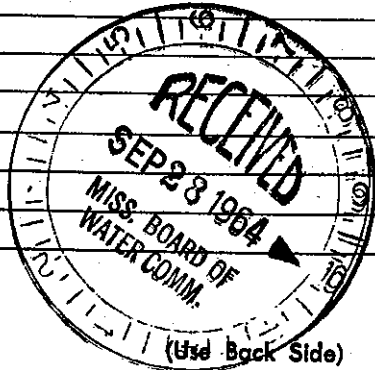

Well No.

Mail this copy to Board of Water Commissioners 429 Miss. St. Jackson, Miss.