

CODED

COD

Bolivar
F 115
7-67

MISSISSIPPI  
 BOARD OF WATER COMMISSIONERS  
 416 North State Street  
 Jackson, Mississippi 39201

8/3/67  
 JTW  
 @2496R

WATER WELL DRILLERS LOG

July 19, 1967 Layne-Central Company Bolivar  
 date well completed firm name county well located

LANDOWNER: R. C. Malone

description of formations encountered

from to

Clay	0	24
Clay & fine sand	24	49
Fine sand	49	70
Coarse sand	70	78
Coarse sand, pea gravel	78	112

Face, Mississippi  
 (mailing address)

WELL LOCATION:

sec. 29 T 23 N R 2 E  
 S


4 miles east of Rosedale  
 (distance) (direction) (nearest town)

WELL PURPOSE: irrigation  
 (home, irrigation, municipal, industrial)

WELL COMPLETION DATA:

- (1) diameter (inches) 8
- (2) total depth (feet) 108
- (3) static water level (feet) 21' 4" above top of ground.
- (4) casing steel 78'  
 (material) (depth)  
 8" if telescope see back.  
 (size)
- (5) screen 30' 78'  
 (length) (depth to top)  
 8" Armco  
 (size) (material)
- (6) pump 15 900  
 (HP) (yield gpm)  
 engine  
 (type power)
- (7) electric log no  
 (yes or no)  
 (organization running log)
- (8) how well bottom plugged plate

CODED

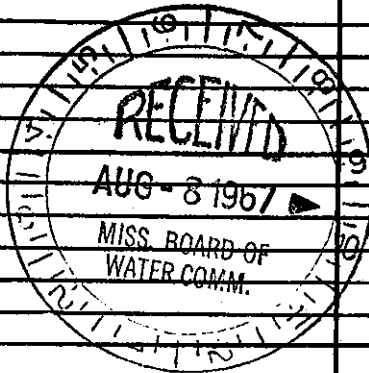

DRILLERS REMARKS: