

*Bolivar*  
*7 117*  
*2-68*

**CODED MISSISSIPPI  
 BOARD OF WATER COMMISSIONERS  
 416 North State Street  
 Jackson, Mississippi 39201**

CODED

**WATER WELL DRILLERS LOG**

*2/12/68* 19 *Decker Well & Supply Co* *Bolivar*  
 date well completed firm name county well located

LANDOWNER:  
*Bill Shelton*  
*Pare, Miss.*  
 (mailing address)

description of formations encountered	from	to
<i>Top dry sand</i>	<i>0</i>	<i>30</i>
<i>good sand</i>	<i>30</i>	<i>128-4</i>

WELL LOCATION:  
 sec *4* T *23* N R *7* W  
*4* miles *So* of *Lumberton*  
 (distance) (direction) (nearest town)

WELL PURPOSE: *Irrigation*  
 (home, irrigation, municipal, industrial)

WELL COMPLETION DATA:

(1) diameter (inches) *16*

(2) total depth (feet) *128-4*

(3) static water level (feet) *26* below above top of ground.

(4) casing *Steel*, *88-4*,  
 (material) (depth)  
 (size) If telescope see back.


(5) screen *40*, *88-4*  
 (length) (depth to top)  
*16*, *steel*  
 (size) (material)

(6) pump *30*, *2000*  
 (HP) (yield gpm)  
*elec*  
 (type power)

(7) electric log \_\_\_\_\_  
 (yes or no)  
 (organization running log)

(8) how well bottom plugged *Complete*

CODED

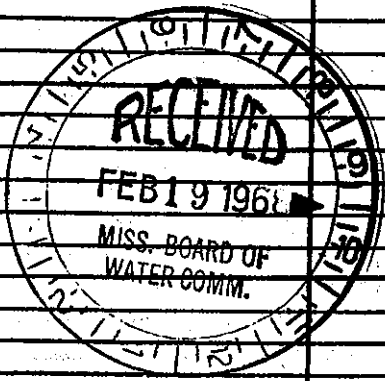

DRILLERS REMARKS: