

CODED

CODED

BOLIVAR

F 122

3-68

MISSISSIPPI  
 BOARD OF WATER COMMISSIONERS  
 416 North State Street  
 Jackson, Mississippi 39201

WATER WELL DRILLERS LOG

3/18  
date well completed

1968 Delta Well & Supply Co  
firm name

Bolivar  
county well located

LANDOWNER:

Robbins + Long

Rosedale

(mailing address)

description of formations encountered

from to

Top Clay	0	2.0
Thin sand	2.0	5.0
Sand	5.0	7.0
sandy gravel	7.0	10.5
limestone	10.5	10.7
sandy gravel	10.7	12.6

WELL LOCATION:


sec. 24 T. 29 N R. 7 W  
 2 miles west of Rose  
 (distance) (direction) (nearest town)

WELL PURPOSE: Irrigation  
 (home, irrigation, municipal, industrial)

WELL COMPLETION DATA:

- (1) diameter (inches) 16
- (2) total depth (feet)
- (3) static water level (feet) 21 below top of ground.
- (4) casing steel (material) (depth)  
 If telescope see back.  
 (size)
- (5) screen 40 (length) (depth to top)  
 16 (size) steel (material)
- (6) pump 50 (HP) 5000 (yield gpm)  
 elec (type power)
- (7) electric log (yes or no)  
 (organization running log)
- (8) how well bottom plugged cement

CODED

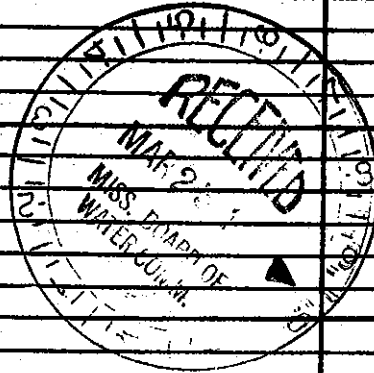

DRILLERS REMARKS: