

BOLIVAR

MISSISSIPPI BOARD OF WATER COMMISSIONERS

~~6-58~~ F126

5-4-65

WATER WELL DRILLERS LOG

Date: 5/4, 1965, Driller: *D. H. Miller Supply Co.* **CODED**
(Name)

(1) Owner of Land: *W. P. Skelton*
(Name)
Pace, Miss.
(Address)

(2) Location: $\frac{1}{4}$, $\frac{1}{4}$, Sec. *10* T23R *70*
3 miles *No. East* of *Rosedale*
(distance) (direction) (Nearest Town)

(3) Topography: (Hilly) (Flat) (Level)

(4) Purpose of Well: *Irrigation*
(Domestic, Irrigation, Municipal, Industrial, Other)

Description & Color of Materials Sand, Clay, Red Clay, Shell, etc.	Thick- ness Feet	Depth Feet
# 1		
<i>Clay</i>	<i>17</i>	
<i>Blue clay</i>	<i>55</i>	<i>72</i>
<i>Fine sand</i>	<i>22</i>	<i>94</i>
<i>Medium sand</i>	<i>30</i>	<i>124-4"</i>
# 2		
<i>Clay</i>	<i>19</i>	
<i>Blue clay</i>	<i>42</i>	<i>61</i>
<i>Fine sand</i>	<i>28</i>	<i>89</i>
<i>Carac sand</i>	<i>46</i>	<i>135</i>
CODED		

Information upon completion of well:

(1) Diameter *16* inches.

(2) Total Depth *#1-124-4"* feet. *#2 135*

(3) Water Level *21* feet below top of ground.

(4) Cased to _____, Size _____

(5) Screen: Size *16*, Length *4-0*

(6) Were any formations sealed against pollution?
_____ yes, _____ no.

If YES depth of formation _____


Why _____

Drillers Remarks: _____

Yield in G. P. M.: *#1-2200 #2-3100*

Type power: *elec*

Crops irrigated & Acreage: *Rice*

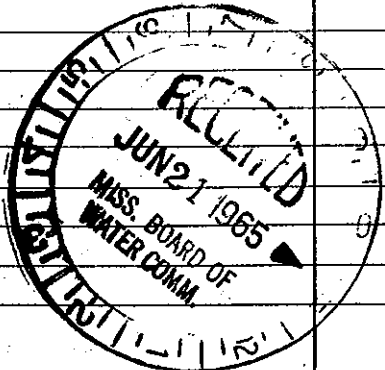

(Use Back Side)

Well No.

Mail this copy to Board of Water Commissioners 429 Miss. St. Jackson, Miss.