

Gw 5228

Coded

4/29/68
JH

Bolivar
F121-55
4-15-68

MISSISSIPPI
BOARD OF WATER COMMISSIONERS
416 North State Street
Jackson, Mississippi 39201

WATER WELL DRILLERS LOG

C2653

April 15, 1968 Layne-Central Company Bolivar
date well completed firm name county well located

LANDOWNER: W. S. Adams

description of formations encountered	from to	
	feet	feet
Clay & sand	0	22
River sand	22	32
Fine sand	32	42
Coarse sand	42	52
Coarse sand	52	60
Coarse & little gravel	60	65
Coarse sand & gravel	65	120
Bottomed out boulders		


Rosedale, Mississippi
(mailing address)

WELL LOCATION:
sec 23 T24 N R 8 E
S W
2 miles east of Rosedale
(distance) (direction) (nearest town)

WELL PURPOSE: irrigation
(home, irrigation, municipal, industrial)

WELL COMPLETION DATA:

- (1) diameter (inches) 16
- (2) total depth (feet) 120
- (3) static water level (feet) 22' 4" ^{below} above top of ground.
- (4) casing steel 70' (material) (depth)
16" (size) If telescope see back.
- (5) screen 50' 120' (length) (depth to top)
16" (size) Armco (material)
- (6) pump 50 2400 (HP) (yield gpm)
electric (type power)
- (7) electric log no (yes or no)
(organization running log)
- (8) how well bottom plugged plate

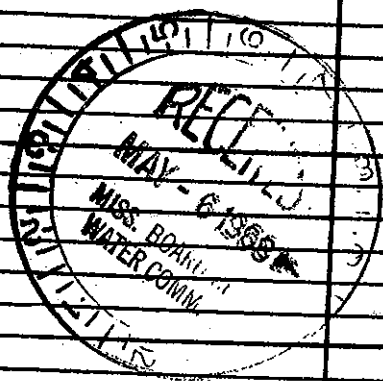

DRILLERS REMARKS: