

BOLIVAR  
F 137  
6/78

MISSISSIPPI  
BOARD OF WATER COMMISSIONERS  
416 North State Street  
Jackson, Mississippi 39201

CODED

WATER WELL DRILLERS LOG

June 19 Cook Drilling Bolivar  
date well completed firm name county well located

LANDOWNER: <u>ROBERT NARON</u>	description of formations encountered	from	to
<u>Cleveland miss</u>	<u>CLAY</u>	<u>0</u>	<u>20</u>
	<u>COARSE SAND</u>	<u>20</u>	<u>30</u>
	<u>COARSE SAND + LARGE GRAIN</u>	<u>30</u>	<u>100</u>


WELL LOCATION:  
sec 17 T 23 N R 7 S  
W  
5 miles North of Pass  
(distance) (direction) (nearest town)

CODED

WELL PURPOSE: IRRIGATION  
(home, irrigation, municipal, industrial)

- WELL COMPLETION DATA:
- (1) diameter (inches) 12"
  - (2) total depth (feet) 100'
  - (3) static water level (feet) 22' below above top of ground.
  - (4) casing Steel 70'  
(material) (depth)  
(size) if telescope see back.
  - (5) screen 30' 70'  
(length) (depth to top)  
12 Steel  
(size) (material)
  - (6) pump 40 1800  
(HP) (yield gpm)  
Diesel  
(type power)
  - (7) electric log NO  
(yes or no)

(organization running log)  
(8) how well bottom plugged Steel Plate

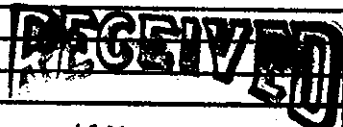

JAN 30 1978

DRILLERS REMARKS:

WATER COMM