

**MISSISSIPPI DEPARTMENT OF NATURAL RESOURCES**  
**Bureau of Land and Water Resources**  
 Southport Mall  
 P.O. Box 10631  
 Jackson, Mississippi 39209 **CODED**  
**WATER WELL DRILLERS LOG**

Bolivar  
F 148  
3-13-81


3-13 1981 Delta Well & Supply Bolivar  
 date well completed firm name county well located

LANDOWNER:	description of formations encountered	from	to
<u>H. H. Harrison</u>	<u>top soil</u>	<u>0</u>	<u>15</u>
<u>Peel Mia</u>	<u>fine sand</u>	<u>15</u>	<u>43</u>
(mailing address)	<u>Course sand</u>	<u>43</u>	<u>70</u>
	<u>Course sand &amp; Gravel</u>	<u>70</u>	<u>113</u>

**WELL LOCATION:**  
 sec 22 T 33 N R 7 E  
3 1/2 miles W of Peel  
 (distance) (direction) (nearest town)

**WELL PURPOSE:** Irrigation  
 (home, irrigation, municipal, industrial)

- WELL COMPLETION DATA:**
- diameter (inches) 12"
  - total depth (feet) 113
  - static water level (feet) 36' below top of ground.
  - casing Steel (material) (depth) \_\_\_\_\_  
 (size) if telescope see back.
  - screen 40' 73 (length) (depth to top)  
12" Steel (size) (material)
  - pump 30 1650 (HP) (yield gpm)  
30 Electric (type power)
  - electric log no (yes or no)
  - (organization running log)
  - how well bottom plugged Steel Plate

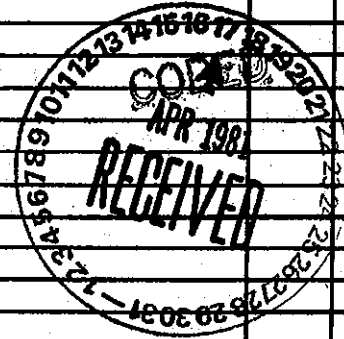

**DRILLERS REMARKS:**