

# State Well Report

## Part 1

Mississippi Department of Environmental Quality  
Office of Land and Water Resources  
P.O. Box 10631  
Jackson, MS 39289-0631  
(601)961-5210  
(601)354-6938 (fax)

For Office Use Only:

Aquifer: \_\_\_\_\_  
Well #: F-199  
L. S. Elevation: \_\_\_\_\_  
E-log #: \_\_\_\_\_

County: Bolivar  
Permit #: GW-39774 ✓  
Driller: Elgin Smith  
Date drilling completed: 7/28/04

State Law requires that this report be prepared by the driller in detail and filed with the Department within 30 days of completion of drilling of the well.

Well Owner Information	Well Location
Owner Name <u>Jimmy Via</u>	Latitude: <u>33° 51' 10"</u> Longitude: <u>90° 56' 58"</u>
Mailing Address: <u>Limit-Up Farms</u>	Method of Lat/Long (circle one): <u>Conventional Survey</u>
<u>PO Box 99</u>	USGS quad, Hand-held GPS, Survey-grade GPS
<u>Rosedale, MS 38769</u>	<u>SE 1/4 SW 1/4 Sec 8</u> Twn <u>23N</u> Rng <u>7W</u>
City _____ State _____ Zip Code _____	Distance _____ Direction _____ Nearest Town _____
Telephone No. ( <u>662</u> ) <u>588-1421</u>	<u>3.5</u> Miles <u>NE</u> of <u>Rosedale</u>

RECEIVED  
AUG 02 2004  
BY OLWR

**Well Data**

Purpose of Well (circle one) Home Industrial Public Supply Irrigation Fish Culture Other: n/a

Date well drilling started: 7/28/04 Date well drilling completed: 7/28/04

If flowing, method of flow regulation: Valve n/a Other (describe) n/a

Static Water Level: 29 feet above or below (circle one) land surface Date measured: 7/29/04

Method of Measurement (circle one) steel tape electric tape air line other: n/a

Hole depth: 122' Well depth: 122' Well grouted to a depth of 10 feet

Type of grout (circle one): Cement Bentonite Mix

Casing length: 72 feet Casing diameter: 16 inches Type of casing: PVC

Screen length: 50 feet Screen diameter: 16 inches Type of screen: PVC

Screen slot size: .050 inches Setting depth: From 72 feet to 122 feet

Type of completion (circle all applicable): Gravel packed Underreamed Telescoped Open hole Natural Development  
Other (describe): n/a

Top of lap pipe or reduction in casing: n/a feet. If telescoped or more than one screen, describe on back of page

Logs run (circle all applicable): No log run Electric Gamma Ray Density Sonic Neutron Other: n/a

Name of organization running log(s): n/a


I certify that the well was drilled, constructed, and completed in accordance with all applicable requirements of the Mississippi Department of Environmental Quality and/or the Mississippi Department of Health regulations and state laws.

Thomas G. Chrestman 0-703

Print Name of Water Well Contractor and License No.

Signature of Water Well Contractor


If well telescopes please sketch below and show depths.

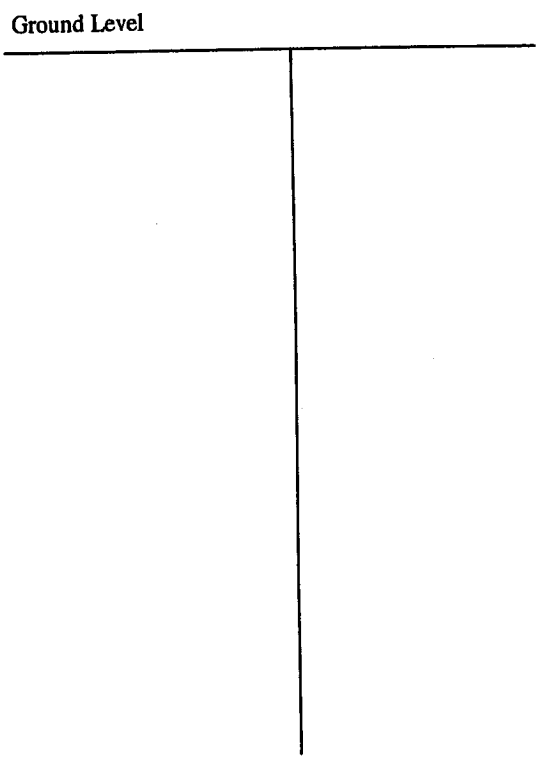

Description of Formations Encountered	From	To
Clay	0	6
Sandy Clay	6	24
Fine Blue Sand	24	48
Sand	48	65
Course Sand & Gravel	65	122

If more than one screen, show location of each on sketch

Sketch the property layout and include the following: 1) the well location; 2) any permanent structures on the property that may aid in locating the well; 3) any roads, power lines, or other items that may aid in locating the property and the well; 4) indicate direction.

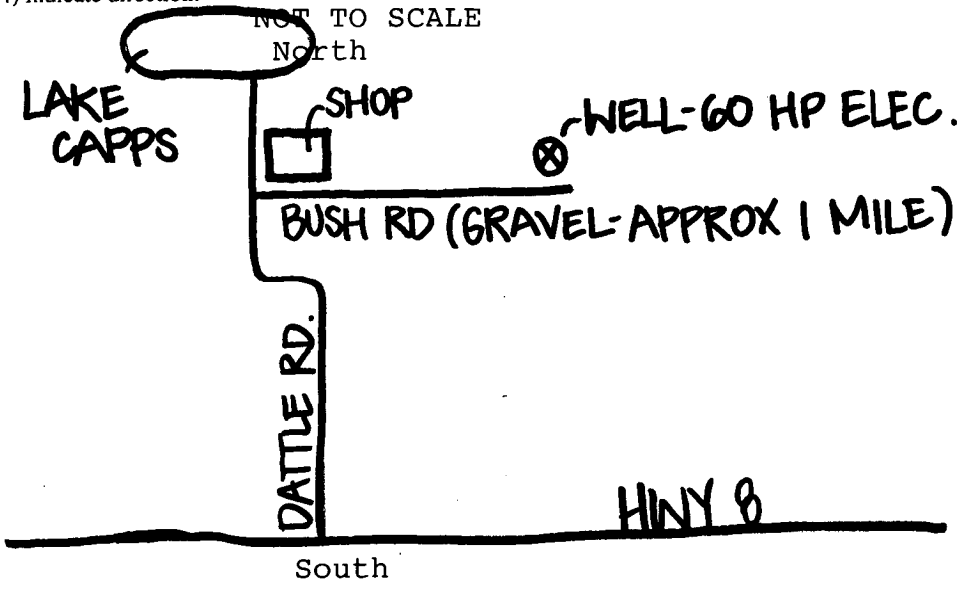

Landowner Name: Limit-Up Farms; Jimmy Via

*Thomas C. Christensen*  
 Signature of Water Well Contractor

# STATE WELL REPORT

## Part 2

**Pump Installer's Completion Report**  
 Mississippi Department of Environmental Quality  
 Office of Land and Water Resources  
 P.O. Box 10631  
 Jackson, MS 39289-0631  
 (601)961-5210  
 (601)354-6938 (fax)

### For Office Use Only:

Aquifer: \_\_\_\_\_  
 Well #: F-199  
 Elevation: \_\_\_\_\_

County: Bolivar  
 Permit #: \_\_\_\_\_  
 Driller: Elgyn Smith  
 Date completed: 7/28/04

**This report should be prepared by the pump installer in detail and filed with the Department within 30 days of the installation of pump.**

Well Owner Information	Well Location
Owner Name: <u>Jimmy Via</u>	Latitude: _____ Longitude: _____
Mailing Address: <u>Limit - Up Farms</u>	Method of Lat/Long (circle one): Conventional Survey,
<u>P.O. Box 99</u>	USGS quad, Hand-held GPS, Survey-grade GPS
<u>Rosedale, MS 38769</u>	_____ 1/4 _____ 1/4 Sec <u>8</u> Twn <u>23N</u> Rng <u>7W</u>
City State Zip Code	Distance Direction Nearest Town
Telephone No. <u>(662) 588-1421</u>	<u>3.5</u> Miles <u>NE</u> of <u>Rosedale</u>

Pump Type Circle one	Power Type Circle one
Air Lift Jet Submersible	Diesel Engine Gasoline Engine Natural Gas
Bucket Piston <u>Turbine</u>	<u>Electric Motor</u> Hand Tractor PTO
Centrifugal Rotary Flowing Well	Windmill Other (specify): _____
Other (specify): _____	Horse Power Rating of Motor: <u>60</u>
Date Pump Installed: <u>7/29/04</u>	Setting Depth: <u>70</u> feet
Rated Pump Capacity: <u>2500</u> Gallons Per Minute	Number of Stages: <u>1</u>

Pump Test Data	Method of Measuring Water Level Circle one
Date Well Tested: <u>Not Tested</u>	Air Line Electric Measuring Line <u>Steel Tape</u>
Static Water Level (A): <u>29</u> Feet Below Land Surface	Other (specify): _____
Pumping Water Level (B): _____ Feet Below Land Surface	For flowing well, measured shut in head: _____ feet
Drawdown [(B) - (A)]: _____ Feet Below Land Surface	Well yielded <u>Not Tested</u> GPM with a drawdown of
Test Pumping Rate: _____ Gallons Per Minute	_____ feet after _____ hours of pumping
Duration of Pump Test (minimum 4 hours): _____ hours	

I HEREBY CERTIFY that the above statements are true to the best of my knowledge.

Thomas G. Christman n/a Thomas G. Christman  
 Print Name of Pump Installer and License No. (if applicable) Signature of Pump Installer

RECEIVED  
 AUG 23 2004  
 BY: OLWR