	State W	ell Report	For Office Use Only:	
Bolivar	Part 1 Mississippi Department of Environmental Quality Office of Land and Water Resources		For Once one only.	
County:			Aquifer:	
Permit # 60041587			Well #: F-216	
Irrigation'Equipment			L. S. Elevation:	
3-6-07		961-5210	E-log #:	
Date drilling completed:		4-6938 (fax)		
·····	]		L	
State Law requires that this rep	ort be prepared by the	driller in detail and filed w	with the Department walling	
30 days of completion of drilling Well Owner Inform	g of the well.	Wel	1 Location	
		22 19.00		
Owner NameScotland Farm	<b>NS</b>	Latitude: <u>53 ° 4 ° 4 4</u>	_" Longitude: <u>90° 58 ' 3</u> 4	
Mailing Address: BOX 98		Method of Lat/Long (circle o	ne): Conventional Survey,	
Mailing Address:			d GPS, Survey-grade GPS	
		-	Twn 23N Rng 8W	
Inverness	MS <u>38753</u>	Nr		
	ate Zip Code	Distance Direction	Nearest Town	
662-265-520		Miles North	of <u>Beulah</u>	
Telephone No. ()				
	Well	Data		
			Other:	
Purpose of Well (circle one) Home In	dustrial Public Supply			
Date well drilling started: $3-6$ .	-07 Date	well drilling completed: 3.	-6-07	
Date well drilling stance.				
If flowing, method of flow regulation: V	alve Other (	describe)		
If flowing, method of flow regulation: V	alve Other (	describe)		
	alve Other (	describe) land surface Date measured		
If flowing, method of flow regulation: V Static Water Level: <u>31'</u> feet	alve Other ( above or below (circle one)	describe)		
If flowing, method of flow regulation: V Static Water Level: <u>31'</u> feet a Method of Measurement (circle one)	alve Other ( above or below (circle one) steel tape electric tap	describe) land surface Date measured e air line other:		
If flowing, method of flow regulation: V Static Water Level: <u>31'</u> feet a Method of Measurement (circle one) ( Hole depth: <u>120</u> Well d	alve Other ( above or below (circle one) steel tape electric tap lepth: 20	describe) land surface Date measured e air line other:		
If flowing, method of flow regulation: V Static Water Level: <u>31'</u> feet a Method of Measurement (circle one) ( Hole depth: <u>120</u> Well d	alve Other ( above or below (circle one) steel tape electric tap lepth: 20	describe) land surface Date measured e air line other: _ Well grouted to a depth of		
If flowing, method of flow regulation: V Static Water Level: <u>31'</u> feet a Method of Measurement (circle one) Hole depth: <u>120</u> Well d Type of grout (circle one): Cement	alve Other ( above or below (circle one) steel tape electric tap lepth: 120 Min	describe) land surface Date measured e air line other: _ Well grouted to a depth of	: <u>3-6-07</u>	
If flowing, method of flow regulation: V Static Water Level: <u>31'</u> feet Method of Measurement (circle one) ( Hole depth: <u>120</u> Well d	alve Other ( above or below (circle one) steel tape electric tap lepth: <u>120</u> Min sing diameter: <u>16</u>	describe) land surface Date measured e air line other: Well grouted to a depth of well grouted to a depth of the state of the state of th	:3_6_07 feet feet PVC_Sch.40	
If flowing, method of flow regulation: V Static Water Level: <u>31'</u> feet a Method of Measurement (circle one) Hole depth: <u>120</u> Well d Type of grout (circle one): Cement Casing length: <u>80</u> feet Ca	alve Other ( above or below (circle one) steel tape electric tap lepth: 120 Min	describe) land surface Date measured e air line other: Well grouted to a depth of C inches Type of casing:	:3_6_07 feet feet PVC_Sch.40	
If flowing, method of flow regulation: V Static Water Level: <u>31'</u> feet a Method of Measurement (circle one) ( Hole depth: <u>120</u> Well d Type of grout (circle one): Cement Casing length: <u>80</u> feet Ca	alve Other ( above or below (circle one) steel tape electric tap lepth: <u>120</u> bentonite Min sing diameter: <u>16</u> reen diameter: <u>16</u>	describe) land surface Date measured e air line other: Well grouted to a depth of well grouted to a depth of the state of the state of th	: 3-6-07 10feet PVC Sch.40 PVC Sch.40	
If flowing, method of flow regulation: V Static Water Level: <u>31'</u> feet a Method of Measurement (circle one) ( Hole depth: <u>120</u> Well d Type of grout (circle one): Cement Casing length: <u>80</u> feet Ca Screen length: <u>40</u> feet Sc Screen slot size: <u>050</u> inches	alve Other ( above or below (circle one) steel tape electric tap lepth: <u>120</u> bentonite Min sing diameter: <u>16</u> reen diameter: <u>16</u> s Setting depth: From	describe) land surface Date measured e air line other: Well grouted to a depth of c inches Type of casing: inches Type of screen: 81feet to	: 3-6-07 10feet PVC Sch.40 PVC Sch.40	
If flowing, method of flow regulation:       V         Static Water Level:       31 ' feet         Method of Measurement (circle one)       (         Hole depth:       120       Well d         Type of grout (circle one):       Cement         Casing length:       80       feet       Ca         Screen length:       40       feet       Screen	alve Other ( above or below (circle one) steel tape electric tap lepth: <u>120</u> bentonite Min sing diameter: <u>16</u> reen diameter: <u>16</u> s Setting depth: From e): Gravel packed Und	describe) land surface Date measured e air line other: Well grouted to a depth of c inches Type of casing: inches Type of screen: 81feet to lerreamed Telescoped Op	: <u>3-6-07</u> <u>10</u> <u>feet</u> <u>PVC Sch.40</u> <u>PVC Sch.40</u> <u>120</u> <u>feet</u>	
If flowing, method of flow regulation: V Static Water Level: <u>31'</u> feet a Method of Measurement (circle one) ( Hole depth: <u>120</u> Well d Type of grout (circle one): Cement Casing length: <u>80</u> feet Ca Screen length: <u>40</u> feet Sc Screen slot size: <u>050</u> inches	alve Other ( above or below (circle one) steel tape electric tap lepth: <u>120</u> bentonite Min sing diameter: <u>16</u> reen diameter: <u>16</u> s Setting depth: From	describe) land surface Date measured e air line other: Well grouted to a depth of c inches Type of casing: inches Type of screen: 81feet to lerreamed Telescoped Op	: <u>3-6-07</u> <u>10</u> <u>feet</u> <u>PVC Sch.40</u> <u>PVC Sch.40</u> <u>120</u> <u>feet</u>	
If flowing, method of flow regulation: V Static Water Level: <u>31'</u> feet a Method of Measurement (circle one) ( Hole depth: <u>120</u> Well d Type of grout (circle one): Cement Casing length: <u>80</u> feet Ca Screen length: <u>40</u> feet Sc Screen slot size: <u>050</u> inches Type of completion (circle all applicable	alve Other ( above or below (circle one) steel tape electric tap lepth: <u>120</u> bentonite Min sing diameter: <u>16</u> second diameter: <u>16</u> second diameter: <u>16</u> second diameter: <u>16</u> or conditioned diameter from be: Gravel packet Und Other (describe):	describe) land surface Date measured e air line other: _ Well grouted to a depth of c inches Type of casing: inches Type of screen: 81feet to lerreamed Telescoped Op	2 3-6-07 10 feet PVC Sch. 40 PVC Sch. 40 120 feet en hole Natural Developme	
If flowing, method of flow regulation: V Static Water Level: <u>31'</u> feet for Method of Measurement (circle one) ( Hole depth: <u>120</u> Well d Type of grout (circle one): Cement Casing length: <u>80</u> feet Ca Screen length: <u>40</u> feet Sc Screen slot size: <u>.050</u> inches Type of completion (circle all applicable	alve Other ( above or below (circle one) steel type electric tap lepth: <u>120</u> bentonite Min sing diameter: <u>16</u> sereen diameter: <u>16</u> s Setting depth: From e): Gravel packel Und Other (describe):feet. If	describe)	2 3-6-07 10 feet PVC Sch. 40 PVC Sch. 40 120 feet en hole Natural Developme screen, describe on back of pa	
If flowing, method of flow regulation: V Static Water Level: <u>31'</u> feet a Method of Measurement (circle one) ( Hole depth: <u>120</u> Well d Type of grout (circle one): Cement Casing length: <u>80</u> feet Ca Screen length: <u>40</u> feet Sc Screen slot size: <u>050</u> inches Type of completion (circle all applicable	alve Other ( above or below (circle one) steel type electric tap lepth: <u>120</u> bentonite Min sing diameter: <u>16</u> sereen diameter: <u>16</u> s Setting depth: From e): Gravel packel Und Other (describe):feet. If	describe)	2 3-6-07 10 feet PVC Sch. 40 PVC Sch. 40 120 feet en hole Natural Developme screen, describe on back of pa	
If flowing, method of flow regulation: V Static Water Level: <u>31'</u> feet a Method of Measurement (circle one) ( Hole depth: <u>120</u> Well d Type of grout (circle one): Cement Casing length: <u>80</u> feet Ca Screen length: <u>40</u> feet Sc Screen slot size: <u>050</u> inches Type of completion (circle all applicable) Top of lap pipe or reduction in casing: Logs run (circle all applicable): No log	alve Other ( above or below (circle one) steel tape electric tap lepth: <u>120</u> bentonite Min sing diameter: <u>16</u> sereen diameter: <u>16</u> sereen diameter: <u>16</u> sereen diameter: <u>16</u> sereen diameter: <u>16</u> feet. If run Electric Gamma Ra	describe)         land surface       Date measured         e       air line       other:         _       Well grouted to a depth of         x	: <u>3-6-07</u> <u>10</u> feet <u>PVC Sch.40</u> <u>PVC Sch.40</u> <u>120</u> feet en hole Natural Development screen, describe on back of pa Other:	
If flowing, method of flow regulation: V Static Water Level: <u>31'</u> feet a Method of Measurement (circle one) ( Hole depth: <u>120</u> Well d Type of grout (circle one): Cement Casing length: <u>80</u> feet Ca Screen length: <u>40</u> feet Sc Screen slot size: <u>.050</u> inches Type of completion (circle all applicable Top of lap pipe or reduction in casing: Logs run (circle all applicable): No log Name of organization running log(s): I certify that the well was drilled, com	alve Other ( above or below (circle one) steel tape electric tap lepth: <u>120</u> bentonite Min sing diameter: <u>16</u> reen diameter: <u>16</u> s Setting depth: From e): Gracel packed Und Other (describe): feet. If run Electric Gamma Russian	describe)		
If flowing, method of flow regulation: V Static Water Level: <u>31'</u> feet a Method of Measurement (circle one) ( Hole depth: <u>120</u> Well d Type of grout (circle one): Cement Casing length: <u>80</u> feet Ca Screen length: <u>40</u> feet Sc Screen slot size: <u>.050</u> inches Type of completion (circle all applicable Top of lap pipe or reduction in casing: Logs run (circle all applicable): No log Name of organization running log(s): I certify that the well was drilled, com	alve Other ( above or below (circle one) steel tape electric tap lepth: <u>120</u> bentonite Min sing diameter: <u>16</u> reen diameter: <u>16</u> s Setting depth: From e): Gracel packed Und Other (describe): feet. If run Electric Gamma Russian	describe)		
If flowing, method of flow regulation: V Static Water Level: <u>31'</u> feet for Method of Measurement (circle one) ( Hole depth: <u>120</u> Well d Type of grout (circle one): Cement Casing length: <u>80</u> feet Ca Screen length: <u>40</u> feet Sc Screen slot size: <u>.050</u> inches Type of completion (circle all applicable) Top of lap pipe or reduction in casing: Logs run (circle all applicable): No log Name of organization running log(s): I certify that the well was drilled, com	alve Other ( above or below (circle one) steel tape electric tap lepth: <u>120</u> bentonite Min sing diameter: <u>16</u> second diamete	describe)		
If flowing, method of flow regulation: V Static Water Level: <u>31'</u> feet for Method of Measurement (circle one) ( Hole depth: <u>120</u> Well d Type of grout (circle one): Cement Casing length: <u>80</u> feet Ca Screen length: <u>40</u> feet Sc Screen slot size: <u>.050</u> inches Type of completion (circle all applicable Top of lap pipe or reduction in casing: Logs run (circle all applicable): No log Name of organization running log(s): I certify that the well was drilled, com Department of Environmental Quality Irrigation Equip	alve Other ( above or below (circle one) steel tape electric tap lepth: <u>120</u> bentonite Min sing diameter: <u>16</u> seen diameter: <u>16</u> seen diameter: <u>16</u> seen diameter: <u>16</u> setting depth: From b): Gracel packed Und Other (describe): feet. If rum Electric Gamma R structed, and completed i by and/or the Mississippi I poment Inc.	describe)		
If flowing, method of flow regulation: V Static Water Level: <u>31'</u> feet for Method of Measurement (circle one) ( Hole depth: <u>120</u> Well d Type of grout (circle one): Cement Casing length: <u>80</u> feet Ca Screen length: <u>40</u> feet Sc Screen slot size: <u>.050</u> inches Type of completion (circle all applicable) Top of lap pipe or reduction in casing: Logs run (circle all applicable): No log Name of organization running log(s): I certify that the well was drilled, com	alve Other ( above or below (circle one) steel tape electric tap lepth: <u>120</u> bentonite Min sing diameter: <u>16</u> second diamete	describe) land surface Date measured e air line other: _ Well grouted to a depth of a inches Type of casing: inches Type of screen: feet to lerreamed Telescoped Op i telescoped or more than one s ay Density Sonic Neutron n accordance with all applica Department of Health regulat		

RECEIVED MAR 2.8 2007 BY: OLVVF If well telescopes please sketch below and show depths.


Ground Level

•••

Description of Formations Encountered	From	То
	0	38
Clay Fine Sand	39	44
Fine Sand/gravel	45	50
Fine Sand/gravel Med. Sand/gravel	51	120
Sana/ geogra		
	1	
	1	
	+	
	+	
	+	
	+	┝──┤
······································		
	1	<u> </u>
· · · · · · · · · · · · · · · · · · ·		
	1	

If more than one screen, show location of each on sketch

Sketch the property layout and include the following: 1) the well location; 2) any permanent structures on the property that may aid in locating the well; 3) any roads, power lines, or other items that may aid in locating the property and the well;
4) indicate direction.

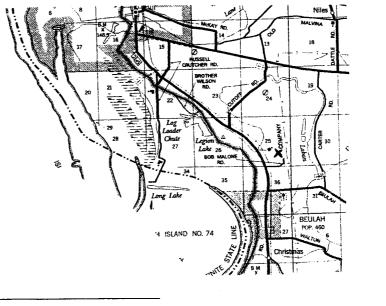

 $\mathbf{x}_{\mathbf{v}}$ 

Signature of Water Well Contractor

Landowner Name:

	STATE WELL REPORT	
County:Bolivar	Part 2 Pump Installer's Completion Report	For Office Use Only:
Permit # $(i) 41.58$ Irrigation Equipment Date completed: 3-6-07	Mississippi Department of Environmental Quality Office of Land and Water Resources P.O. Box 10631 Jackson, MS 39289-0631 (601)961-5210 (601)354-6938 (fax)	Aquifer: Well #: <u>F-216</u> Elevation:

1

. .

## This report should be prepared by the pump installer in detail and filed with the Department within 30 days of the installation of pump.

Well Owner Information			Well Location		
OwnerName: Scotland Farms Mailing Address: Box 98			Latitude:Longitude:		
			Method of Lat/Long (circle one): Conventional Survey,		
:	• ••	* 	USGS quad, Hand-held GPS, Survey-grade GPS		
	Inverness MS	38753	SW 1/4 SE 1/4 Sec 25 Twn 23N Rng 8W		
	City State 662-265-5209	Zip Code .	Distance Direction Nearest Town		
Telephone No. (	)		<u>1</u> Miles North of Beulah		

Pump Type Circle one		Power Type Circle one			
AirLift	Jet	Submersible	Diesel Engine	Gasoline Engine	Natural Gas
Bucket	Piston	Turbine	Electric Motor	Hand	Tractor PTO
Centrifugal	Rotary	Flowing Well	Windmill	Other (specify):	
Other (specify):			Horse Power Rating	of Motor: 60	
Date Pump Installed:	3-	-6-07	Setting Depth:	70	_feet
Rated Pump Capacity:	2800±	Gallons Per Minute	Number of Stages:	1	_

Pump Test Data	Method of Measuring Water Level		
Date Well Tested:	Circle one		
Static Water Level (A):Feet Below Land Surface	Air Line Electric Measuring Line Steel Tape		
Pumping Water Level (B):Feet Below Land Surface	Other (specify):		
Drawdown [(B) - (A)]:Feet Below Land Surface	For flowing well, measured shut in head:feet		
Test Pumping Rate:Gallons Per Minute	Well yielded GPM with a drawdown of		
Duration of Pump Test (minimum 4 hours):hours	feet afterhours of pumping		

I HEREBY CERTIFY that the above statements are true to the best of	my knowigligg	
Patrick M. Chism 0695	Patril Mil	RECEIVER
Print Name of Pump Installer and License No. (if applicable)	Signature of Pump Installer	
		MAR 2 8 2007

BY: OLWA