JK.	
20	•

County Bolivan
Регли # <u>6W43</u> 990
Driller Clarence Me Musty
Date drilling completed 3-15-15

# **State Well Report**

Part 1 — Driller's Log
Mississippi Department of Environmental Quality
Office of Land and Water Resources

P.O. Box 2309 Jackson, MS 39225 (601)961- 5210 (801)961- 5228 (fax)

For Office Use Only:			
Aquifer.	_	246	
Well#:			
1 S Elevation			
R-log#	,,,,,		

State I aw requires that this report be prepared by the license holder responsible for the work and filed with the Department at the above undress within 30 days of completion of drilling of the well or borchule. Information on Well Owner Well or Borchole Location (Landowner if borehole is not for a water well) Latitude: 1/33 . 49 . 31,38" Longitude 1150 . 36 . 05,06" Method of Lat/Long (circle one): Conventional Survey, Mailing Address: USGS quad. Hand-beld GPS) Survey-grade GPS Bryant /N 47326 City State Zip Code NW1/4 SW /4 Sec 21 /Twn 23N Rng 7W Telephone No. (8/2) 863-4541 Well #1 Date drilling started: 3-15-10 Date drilling completed: 3-15-10 Hole depth: 120 Hole diameter: 26" Location of the source of any surface water used for drilling: Method of dasing and volume of Chlorine used in drilling and development: Logs run (circle all applicable); No tog run Electric Gamma Ray Density Sonic Neutron Other: Name of organization running log(a): Purpose of borehole (check one): Water Well \_\_ Goulechnical/Geological lavestigation\_\_\_ Ground Source Heat Pump Seismic Survey\_\_\_ Other (describe)\_ If dritting is not related to water well construction, skip the remainder of this block Purpose of Well (check one): Home \_\_\_ Industrial\_ Public Supply\_\_ Irrigation\_\_/Fish Culture \_\_\_ Other: If a flowing well, method of flow regulation: Valve \_\_\_\_\_ Other (describe) \_\_\_\_\_\_ Static Water Level: 35 feet above or to low (circle one) land surface Date measured: 3-/6-/0 Method of Measurement (circle one) steel tape electric tope other; \_\_ air line Well depth: /20' Well grouted to a depth of /D feet Type of grout (circle one) Neut Cement Bentonite Mix Casing length: 70 lect Casing diameter. 16 inches Type of casing: PVC Screen diameter: 16 inches Screen length: 50 feet Type of survey: PVC Screen slot size: 050 inches Setting depth: From 70 feet to 120 feet Type of completion (circle all applicable): Gravel packed Underreamed Telescoped Open hole Natural Development Other (describe): Top of lap pipe or reduction in ensing: N feet. If telescoped or more than one screen, describe on next page

Form: OLWR-SWR-1A (04/08)

F246


### The sketch below only required for water wells

If well telescopes, show depths on sketch. Ground Level.		
	• •	

## Description of formations encountered must be provided for all wells and boreholes, unless specifically exempted by regulations

Description of Formations Encountered	From (depth)	l'o (depth)
Clay 1 Fire Sand	Ground Level	15
E'nk Sand	15	40
Clan	40	45
Fine Sand	45	50
Medium Sand	30	65
Medium Coarse Sail & gravel	65	80
Coorsesand graves	80	110
Median Sand	//0	1/2
Course Sund & gravel	112	120
		I
	ļ	
N-10-10-10-10-10-10-10-10-10-10-10-10-10-		
1100		
		1 -1

If more than one screen, show location of each on sketch

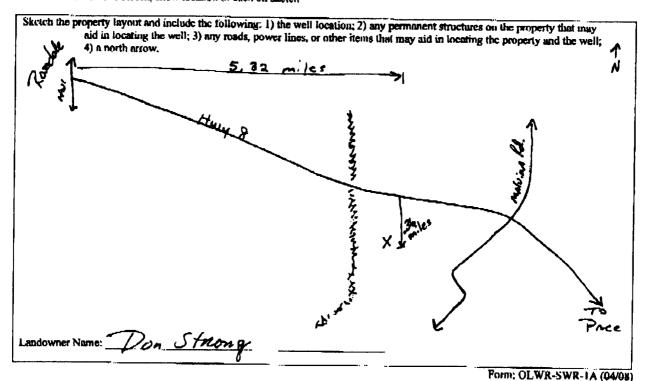

I certify that the well/burchole was drilled, constructed, and completed in accordance with all applicable requirements of the Mississippi Department of Environmental Quality and the Mississippi Department of Health regulations, if applicable, and state

Print Name of Responsible Licensee and License No.

### STATE WELL REPORT 1301. JAR Part 2 County For Office Use Only: Pump Installer's Completion Report Permit # Mississippi Department of Environmental Quality F 246 Aquifer. Office of Land and Water Resources Duller John Rubo t P.O. Box 2309 Jackson, MS 39225 Date completed 3-16-10 (601)961-5210 Elevation. (601)961-5228 (fax) Copy information from block on Part 1 This part of the report must be completed by a licensed water well contractor or a licensed pump installer. A copy of Part 1 of the report must be attached and both parts filed with the Department at the above address within 30 days of well completion. Well Owner Information Well Location Don Strong Latitude: 133 49 34, 38 Longitude: W 90 56 0506" Owner Name: 8341 North 400 East Mailing Address: Method of Lat/Long (check one): Conventional Survey\_\_\_\_, USGS quad , Hand-held GPS - Survey-grade GPS Brygnt (N 47326 W West JI TOBN R 7W Direction Nearest Town Telephone No. (812) 863 - 45 Y / Well #1 Rosedme Pump Type Power Type Circle one Circle one Air Lift Diesel Engine Jet Submersible Gasoline Engine Natural Gas Bucket Piston Turbine ) electric Motor Hand Tractor PTO Centrifugai Rotary Flowing Well Windmill Other (specify): Other (specify): Horse Power Rating of Motor: \_\_\_\_ 40 3-16-10 Date Pump Installed: 70 feet Setting Depth: Rated Pump Capacity: 2500 Gallons Per Minute Number of Stages: Pump Test Data Method of Measuring Water Level Circle one Date Well Tested: NOT TES 7 ED Air Line Electric Measuring Linc Steel Tape Static Water Level (A): 35 Feet Below Land Surface Other (specify): \_\_\_\_\_ Pumping Water Level (B) N/A Feet Below Land Surface Drawdown [(B) (A)]: A/A Feet Below Land Surface For flowing well, measured shut in head:

	· · · · · · · · · · · · · · · · · · ·
I HEREBY CERTIFY that the above statements are true to the bea	t of my knowledge.
	· - 1
Miller 17-703	Clarkon miller
Print Number of Pump Installer and Liconso No. (if applicable)	Signature of Pump Installer

Well yielded \_\_\_\_

With Gallons Per Minute

Duration of Pump Test (minimum 4 hours): \_\_\_\_\_\_\_ hours

Test Pumping Rate:

Form: OLWR-SWR-1B (04/08)

\_\_\_\_GI'M with a drawdown of

leet after hours of pumping