

Bolivar MISSISSIPPI BOARD OF WATER COMMISSIONERS

F-1002

4-66

WATER WELL DRILLERS LOG

Date: 4/20, 1966, Driller: Delta Well Supply County Polk  
(Name)

(1) Owner of Land	Description & Color of Materials Sand, Clay, Red Clay, Shell, etc.	Thick- ness Feet	Depth Feet
<u>Robins &amp; Long</u> <small>(Name)</small>	<u>Top Soil &amp; Blue</u>		
<u>Rosedale</u> <small>(Address)</small>	<u>sand &amp; clay</u>	<u>4 1/2</u>	
(2) Location: <u>1/4</u> , <u>1/4</u> , Sec. <u>1</u> T. <u>1</u> R. <u>1</u>	<u>Small pebbles</u>	<u>9</u>	<u>50</u>
<u>1</u> miles <u>East</u> of <u>Rosedale</u> <small>(distance) (direction) (Nearest Town)</small>	<u>Coarse sand &amp;</u>		
(3) Topography: <u>Level</u> <small>(Hilly) (Flat) (Level)</small>	<u>gravel</u>	<u>71</u>	<u>121</u>
(4) Purpose of Well: <u>Irrigation</u> <small>(Domestic Irrigation Municipal, Industrial, Other)</small>			

Information upon completion of well:

(1) Diameter 16 inches.

(2) Total Depth 121 feet.

(3) Water Level 14 feet below top of ground.

(4) Cased to \_\_\_\_\_, Size \_\_\_\_\_


(5) Screen: Size 16, Length 40

(6) Were any formations sealed against pollution?  
 \_\_\_\_\_ yes, \_\_\_\_\_ no.

If YES depth of formation \_\_\_\_\_

Why \_\_\_\_\_

Drillers Remarks: \_\_\_\_\_

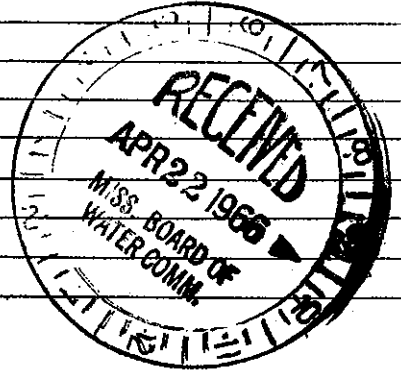

(Use Back Side)

Well No.

Mail this copy to Board of Water Commissioners 429 Miss. St. Jackson, Mis: