


BOLIVAR MISSISSIPPI BOARD OF WATER COMMISSIONERS

WATER WELL DRILLERS LOG 11/23/64
 11-16-64 06
 MS 1896

Date: Nov. 16, 1964, Driller: Layne-Central Company County Bolivar

(Name)

(1) Owner of Land: <u>Pace Water Association, Inc.</u> (Name)	Description & Color of Materials Sand, Clay, Red Clay, Shell, etc.	Thick- ness Feet	Depth Feet
<u>Pace, Mississippi</u> (Address)	<u>Buckshot</u>	<u>3</u>	<u>3</u>
	<u>Clay</u>	<u>15</u>	<u>18</u>
	<u>Sand</u>	<u>59</u>	<u>80</u>
(2) Location: <u>3/4</u> , <u>3/4</u> , Sec. <u>31 T23N 26 W R7W</u>	<u>Sand & gravel</u>	<u>65</u>	<u>145</u>
<u>3/4</u> miles <u>31 T23N</u> of <u>Pace</u> (distance) (direction) (Nearest Town)	<u>Brittle sandy clay</u>	<u>67</u>	<u>212</u>
(3) Topography: <u>flat</u> (Hilly) (Flat) (Level)	<u>Clay & strks. sand</u>	<u>35</u>	<u>247</u>
(4) Purpose of Well: <u>Municipal</u> (Domestic Irrigation Municipal, Industrial, Other)	<u>Sandy clay strks. of lignite</u>	<u>22</u>	<u>269</u>
Information upon completion of well:	<u>Sand strks. of clay</u>	<u>80</u>	<u>349</u>
(1) Diameter <u>6x8</u> inches.	<u>Clay</u>	<u>12</u>	<u>361</u>
(2) Total Depth <u>889</u> feet.	<u>Sand</u>	<u>36</u>	<u>397</u>
(3) Water Level <u>23</u> feet below top of ground.	<u>Clay</u>	<u>10</u>	<u>407</u>
(4) Cased to <u>833'</u> , Size <u>8"</u>	<u>Sand (fine)</u>	<u>174</u>	<u>581</u>
(5) Screen: Size <u>6"</u> , Length <u>40'</u>	<u>Sandy shale</u>	<u>15</u>	<u>596</u>
B.P.V. & tail pipe, <u>6" x 11'</u>	<u>Sand</u>	<u>27</u>	<u>623</u>
(6) Were any formations sealed against pollution?	<u>Sandy shale & lignite</u>	<u>57</u>	<u>680</u>
<u>yes</u> yes, <u>no</u> no.	<u>Clay & sand streaked</u>	<u>68</u>	<u>748</u>
If YES depth of formation <u>Cemented</u> , has	<u>Sandy clay (gummy strks.)</u>	<u>48</u>	<u>796</u>
mechanical seal and B.P.V.	<u>Sand</u>	<u>87</u>	<u>883</u>
Why _____	<u>Shale</u>	<u>6</u>	<u>889</u>
Drillers Remarks: _____			
<u>878</u>			

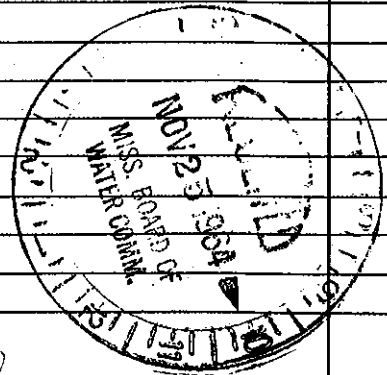

(Use Back Side)

Well No.

Mail this copy to Board of Water Commissioners 429 Miss. St. Jackson, Miss.