

Bolivar
6-60
3-60

MISSISSIPPI BOARD OF WATER COMMISSIONERS

WATER WELL DRILLERS LOG


1/15/66
2700
CODED

Date: March 12, 1960, Driller: Layne-Central Company County Bolivar

(Name)

(1) Owner of land: <u>Hall Farms</u> (Name)	Description & Color of Materials Sand, Clay, Red Clay, Shell, etc.	Thick- ness Feet	Depth Feet
<u>Merigold, Mississippi</u> (Address)	Not available in our records.		
(2) Location: <u>1/4, 1/4, Sec. 19, T23R6</u> <u>Josephine Plantation</u> <u>miles north</u> of <u>Pace</u> (distance) (direction) (Nearest Town)			
(3) Topography: <u>flat</u> (Hilly) (Flat) (Level)			
(4) Purpose of Well: <u>irrigation</u> (Domestic Irrigation Municipal, Industrial, Other)			
Information upon completion of well:			
(1) Diameter <u>16</u> inches.			
(2) Total Depth <u>121</u> feet.			
(3) Water Level _____ feet below top of ground.			
(4) Cased to <u>71'</u> , Size <u>16"</u>			
(5) Screen: Size <u>16"</u> , Length <u>50'</u>			
(6) Were any formations sealed against pollution? <u>no</u> yes, <u>no</u> no.			
If YES depth of formation _____			
Why _____			
Drillers Remarks: <u>2500 GPM.</u>			
<u>Electric power.</u>			

CODED

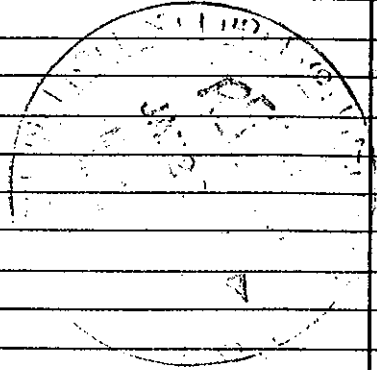

(Use Back Side)

Well No.

Mail this copy to Board of Water Commissioners 429 Miss. St. Jackson, Miss.