

BOLIVAR
G-61
8-8-60

MISSISSIPPI BOARD OF WATER COMMISSIONERS

301

WATER WELL DRILLERS LOG

CODED

Date: 8-8, 1960, Driller: Layne-Central Bolivar
Cleveland, Miss.

Rayner Hardware Co.

(1) Owner of Land: E.D. Rayner
(Name)
Merigold, Mississippi
(Address)
(2) Location: ^{21 23 5} 1/4, 1/4, Sec. 4 T23R6
6 miles West of Merigold
(distance) (direction) (Nearest Town)


Description & Color of Materials Sand, Clay, Red Clay, Shell, etc.	Thick- ness Feet	Depth Feet
Clay	38	38
C. sand & pea gravel	60	98
Big rocks	10	108

(3) Topography: (Hilly) (Flat) (Level)
(4) Purpose of Well: Irrigation
(Domestic, Irrigation, Municipal, Industrial, Other)

Information upon completion of well:
(1) Diameter 12" inches.
(2) Total Depth 108 feet.
(3) Water Level 16' feet below top of ground.
(4) Cased to 78', Size m12"
(5) Screen: Size 12", Length 30'

CODED

(6) Were any formations sealed against pollution?
_____yes, no.
If YES depth of formation _____
Why _____
Drillers Remarks: _____

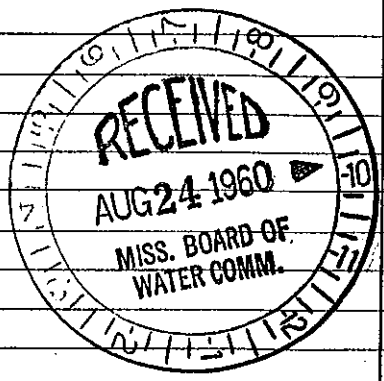

Well No

(Use Back Side)

Mail this copy to Board of Water Commissioners 429 Miss. St. Jackson. Miss