

BOLIVAR MISSISSIPPI BOARD OF WATER COMMISSIONERS

G-62

5-30-62

WATER WELL DRILLERS LOG

Date: 5/30, 1962, Driller: Fine County Pump & Drilling

(Name)

CODED

		Description & Color of Materials Sand, Clay, Red Clay, Shell, etc.	Thickness Feet	Depth Feet
(1) Owner of Land:	<u>R.C. Malone</u> (Name)			
	<u>Pace, Miss</u> (Address)	<u>clay</u>	<u>32</u>	<u>32</u>
		<u>fine sand</u>	<u>8</u>	<u>40</u>
		<u>large sand</u>		
		<u>red silted</u>	<u>48</u>	<u>88</u>
(2) Location:	<u>2</u> miles <u>NE</u> of <u>Pace</u> (distance) (direction) (Nearest Town)			
(3) Topography:	<input checked="" type="checkbox"/> (Level)			
(4) Purpose of Well:	<u>irrigation</u> (Domestic Irrigation, Municipal, Industrial, Other)			

Information upon completion of well:


- (1) Diameter 6 inches.
- (2) Total Depth 88 feet.
- (3) Water Level 16 feet below top of ground.
- (4) Cased to 40, Size 6.
- (5) Screen: Size 6, Length 48.
- (6) Were any formations sealed against pollution?
 yes, no.

If YES depth of formation _____

Why _____

Drillers Remarks: _____

CODED

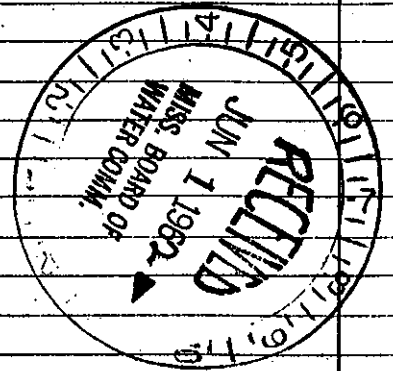

(Use Back Side)

Well No.

Mail this copy to Board of Water Commissioners 429 Miss. St. Jackson, Miss