

BOLIVAR MISSISSIPPI BOARD OF WATER COMMISSIONERS


~~B~~G-63
7-8-64

WATER WELL DRILLERS LOG

Date: 7/8, 1964, Driller: Delta Wells, Drilling Co., Bolivar
(Name)

CODED

(1) Owner of Land: <u>J. R. Smith III</u> (Name)	Description & Color of Materials Sand, Clay, Red Clay, Shell, etc.	Thick- ness Feet	Depth Feet
<u>Merigold</u> (Address)	<u>sand clay</u>	<u>20</u>	
(2) Location: <u>1/4, 1/4, Sec. 25-23-R6</u>	<u>Fine sand</u>	<u>45</u>	<u>65</u>
<u>2 1/2</u> miles <u>So. West</u> of <u>Merigold</u> (distance) (direction) (Nearest Town)	<u>Clay</u>	<u>20</u>	<u>85</u>
(3) Topography: <u>V</u> (Hilly) (Flat) (Level)	<u>sand & gravel</u>	<u>42</u>	<u>127</u>
(4) Purpose of Well: <u>Hog Farm</u> (Domestic, Irrigation, Municipal, Industrial, Other)	<u>Rock</u>	<u>2</u>	<u>129</u>
Information upon completion of well:	<u>sand course</u>	<u>14</u>	<u>143</u>
(1) Diameter <u>5 x 2 1/2</u> inches.	<u>Rock</u>	<u>1</u>	<u>144</u>
(2) Total Depth <u>780</u> feet.	<u>Clay</u>	<u>10</u>	<u>154</u>
(3) Water Level <u>22</u> feet below top of ground.	<u>Fine sand</u>	<u>56</u>	<u>210</u>
(4) Cased to _____, Size _____	<u>Clay</u>	<u>66</u>	<u>276</u>
(5) Screen: Size <u>2 1/2</u> , Length <u>30 ft.</u>	<u>sand F to C</u>	<u>89</u>	<u>365</u>
(6) Were any formations sealed against pollution? _____ yes, _____ no.	<u>Clay</u>	<u>5</u>	<u>370</u>
If YES, depth of formation _____	<u>sand F</u>	<u>6</u>	<u>376</u>
Why _____	<u>Clay</u>	<u>8</u>	<u>384</u>
Drillers Remarks: _____	<u>sand</u>	<u>58</u>	<u>442</u>
_____	<u>Clay course</u>	<u>255</u>	<u>697</u>
_____	<u>sand clay</u>	<u>78</u>	<u>775</u>
_____	<u>" Mottled Course</u>	<u>37</u>	<u>812</u>
_____	<u>Hard clay ?</u>		

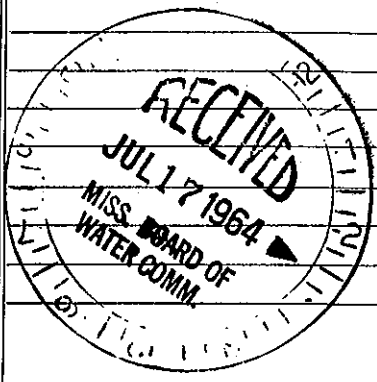

(Use Back Side)

Well No.

Mail this copy to Board of Water Commissioners 429 Miss. St. Jackson, Miss