

BOLIVAR MISSISSIPPI BOARD OF WATER COMMISSIONERS

~~10~~ G-65

1-14-66

WATER WELL DRILLERS LOG

BHANE GAS CO

CODED

Bolivar

Date: 1/14, 1966, Driller: OF GREENWOOD County ~~Lowell~~

(Name)

		Description & Color of Materials Sand, Clay, Red Clay, Shell, etc.	Thick- ness Feet	Depth Feet
(1) Owner of Land:	BOB YEAGER (Name)	0-18 Gravel	14	14
	SKENE, MISS. (Address)	65 SAND	49	65
(2) Location:	$\frac{1}{4}$, $\frac{1}{4}$, Sec. 23, 19, 15, 22, 23 R 6	142 SAND & GRAVEL	84	142
	5 miles EAST of SKENE (distance) (direction) (Nearest Town)	207 SHALE	65	207
(3) Topography:	FLAT (Hilly) (Flat) (Level)	619 SAND & SHALE STREAK	41	619
(4) Purpose of Well:	DOMESTIC (Domestic Irrigation Municipal, Industrial, Other)	673 SANDY SHALE	54	673
		762 SAND & SHALE	89	762
		814 SAND	52	814
		BOTTOM OF WELL 797		

Information upon completion of well:

- (1) Diameter $4\frac{1}{2}$ inches.
- (2) Total Depth 797 feet.
- (3) Water Level 26 feet below top of ground. 126', 4"
- (4) Cased to 671', Size 2"
- (5) Screen: Size 2", Length 20'
- (6) Were any formations sealed against pollution?
yes, no.

If YES depth of formation _____


Why _____

Drillers Remarks: _____

Yield in G. P. M.: 18

Type power: ELECTRIC

Crops irrigated & Acreage: NONE

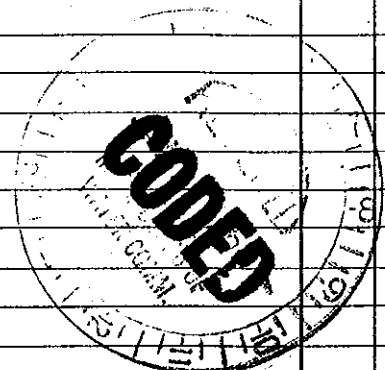

(Use Back Side)

Well No.

Mail this copy to Board of Water Commissioners 429 Miss. St. Jackson, Miss.