

BOLIVAR MISSISSIPPI BOARD OF WATER COMMISSIONERS

~~672~~ ^{F104}

WATER WELL DRILLERS LOG

CODED

2-27-61

Date: 2/27, 1961, Driller: Delta Well Supply Co. Bolivar County, Bolivar
(Name)

(1) Owner of Land:	Description & Color of Materials Sand, Clay, Red Clay, Shell, etc.	Thick- ness Feet	Depth Feet
<u>W. P. Sketton</u> (Name)	<u>Top soil</u>	<u>12</u>	<u>12</u>
<u>Paul Miss.</u> (Address)	<u>White sand</u>	<u>8</u>	<u>20</u>
(2) Location: <u>North-west</u> , Sec. <u>29</u> T <u>23</u> R <u>6</u>	<u>Clay</u>	<u>4</u>	<u>24</u>
_____ miles _____, of _____ (distance) (direction) (Nearest Town)	<u>subl. Fine</u>	<u>40</u>	<u>64</u>
(3) Topography: <u>Flat</u> (Hilly) (Flat) (Level)	" <u>Coarse</u>	<u>20</u>	<u>84</u>
(4) Purpose of Well: <u>Irrigation</u> (Domestic Irrigation Municipal, Industrial, Other)	" <u>Gravel</u>	<u>41</u>	<u>125</u>

CODED


Information upon completion of well:

- (1) Diameter 12 inches.
- (2) Total Depth 125'-7" feet.
- (3) Water Level 19' feet below top of ground.
- (4) Cased to _____, Size _____
- (5) Screen: Size 12 in, Length 40 ft
- (6) Were any formations sealed against pollution?
_____ yes, no.

If YES depth of formation _____

Why _____

Drillers Remarks: _____

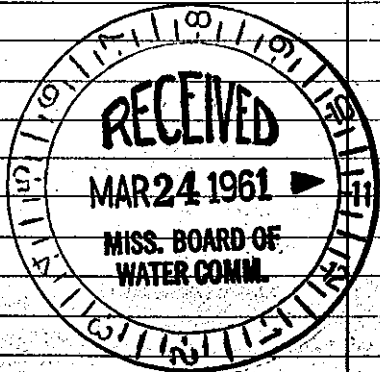

Well No.

(Use Back Side)

Mail this copy to Board of Water Commissioners 429 Miss. St. Jackson, Miss