

G 4374
102

4-14-62


WATER WELL DRILLERS LOG

CODED 6/17/62
C12 3/6

G.W. LeBell

Date: April 14, 1962, Driller: Layne-Central Company County Bolivar
(Name)

(1) Owner of Land: <u>Hall Farms</u> (Name)	Description & Color of Materials Sand, Clay, Red Clay, Shell, etc.	Thick- ness Feet	Depth Feet
<u>Cleveland, Mississippi</u> (Address)	Clay	14	14
(2) Location: <u>1/4, 1/4, Sec. 19 T 23N R 6W</u>	Fine sand	22	36
<u>2 miles north</u> of <u>Pace</u> (distance) (direction) (Nearest Town)	Medium sand	20	56
(3) Topography: <u>flat</u> (Hilly) (Flat) (Level)	Coarse sand	15	71
(4) Purpose of Well: <u>irrigation</u> (Domestic Irrigation Municipal, Industrial, Other)	Coarse sand, pea gravel	41	112
Information upon completion of well:			
(1) Diameter <u>12</u> inches.			
(2) Total Depth <u>112</u> feet.			
(3) Water Level <u>11'-3"</u> feet below top of ground.			
(4) Cased to <u>74'</u> , Size <u>12"</u>			
(5) Screen: Size <u>12"</u> , Length <u>38'</u>			
(6) Were any formations sealed against pollution?			
<u> </u> yes, <u>No</u> no.			
If YES depth of formation _____			
Why _____			
Drillers Remarks: _____			

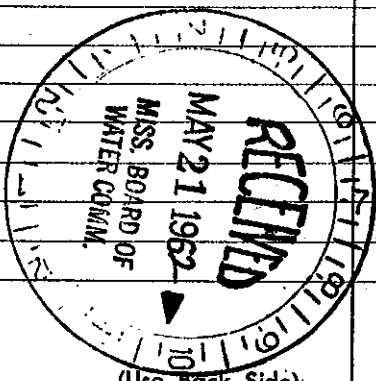

Well No.