

BOLIVAR MISSISSIPPI BOARD OF WATER COMMISSIONERS
G 76 90
2-4-63 WATER WELL DRILLERS LOG *5/10/63 C-1792*

Date: Feb. 4, 19 63, Driller: Layne-Central Company County Bolivar

(Name)

(1) Owner of Land: <u>Hall Farms</u> (Name)	Description & Color of Materials Sand, Clay, Red Clay, Shell, etc.	Thick- ness Feet	Depth Feet
<u>Cleveland, Mississippi</u> (Address)	Clay	24	24
(2) Location: <u>1/4, 1/4, Sec. 20 T23N R6W</u>	Coarse sand	22	46
<u>2</u> miles <u>north</u> , of <u>Pace</u> (distance) (direction) (Nearest Town)	Coarse sand, pea gravel	40	86
(3) Topography: <u>flat</u> (Hilly) (Flat) (Level)	Coarse sand, gravel	12	98
(4) Purpose of Well: <u>irrigation</u> (Domestic Irrigation Municipal, Industrial, Other)			

CODED


Information upon completion of well:

- (1) Diameter 12 inches.
- (2) Total Depth 98 feet.
- (3) Water Level 14'-4" feet below top of ground.
- (4) Cased to 58', Size 12"
- (5) Screen: Size 12", Length 40'
- (6) Were any formations sealed against pollution?
 yes, no.

If YES depth of formation _____

Why _____

Drillers Remarks: _____

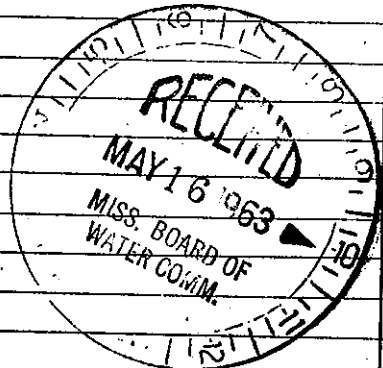

Well No.

(Use Back Side)

Original copy - mail to Jackson
 Retain this copy for your office files.